Paid 50.00 6-6-00

IREDELL COUNTY HEALTH DEPARTMENT

STATESVILLE 704-878-5305 MOORESVILLE 704-664-5281

IMPROVEMENT PERMIT / AUTHORIZATION TO CONSTRUCT / OPERATION PERMIT / EXISTING SYSTEM INSPECTION

PERMIT# 078426 PIN# 4636 83 7667 DATE 6/6/00

OWNER OR CONTRACTOR Tim Whelan PHONE: Business 400 - 8932 Home

ADDRESS 407 Canvasback Rd. Mooresville, NC. 28115

LOCATION Canvasback Rd. 1100 Tl Canvasback ~ 1.2 miles on (L)

SUBDIVISION Woodland Hills BLOCK / SECTION 2 LOT 18 LOT AREA .82 Ac SITE CLASS. PS DESIGN FLOW 480 L.T.A.R. .25

Septic Tank: 1000 Gallons; STB 312 Date 3/17/00

Pump Tank: 1000 Gallons; PT 283 Date 4/19/00

Pump Make: ZOELLER Model E-140A Serial No. 9-94

Nitrification Field: No Fields 1 Square Feet 1440 Linear Feet 480

No Lines 6 Trench Width 36" Max Trench Bottom Depth 36" ~~Gravel Depth~~ SAND.

[X] New System [ ] Repair System Type: I, II, (III), IV, V, VI

System Description: PM - CH. PLASTIC OR NDS

Repair System Description: SAME

Maintenance Agreement Required: [ ] Yes [X] No

[X] House/Mod. Home [ ] Mobile Home [ ] Business [ ] Other

No. Bedrooms 4 No. Bathrooms 3 No. Employees


[ ] Slab [ ] Crawl Space [X] Basement w/plumbing [ ] Basement wo/plumbing

Water Supply: [ ] Individual [ ] Public [X] Community


Comments:/Conditions:

Comments:/Conditions:

INITIAL SITE SKETCH (1"=40')

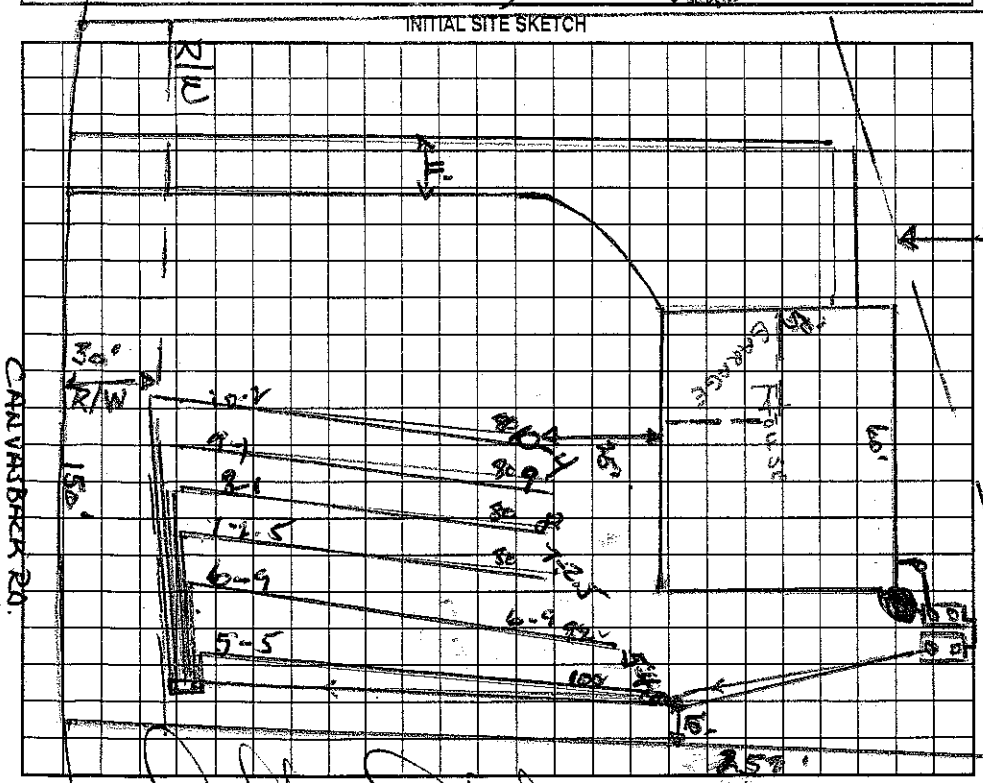

AS BUILT SKETCH

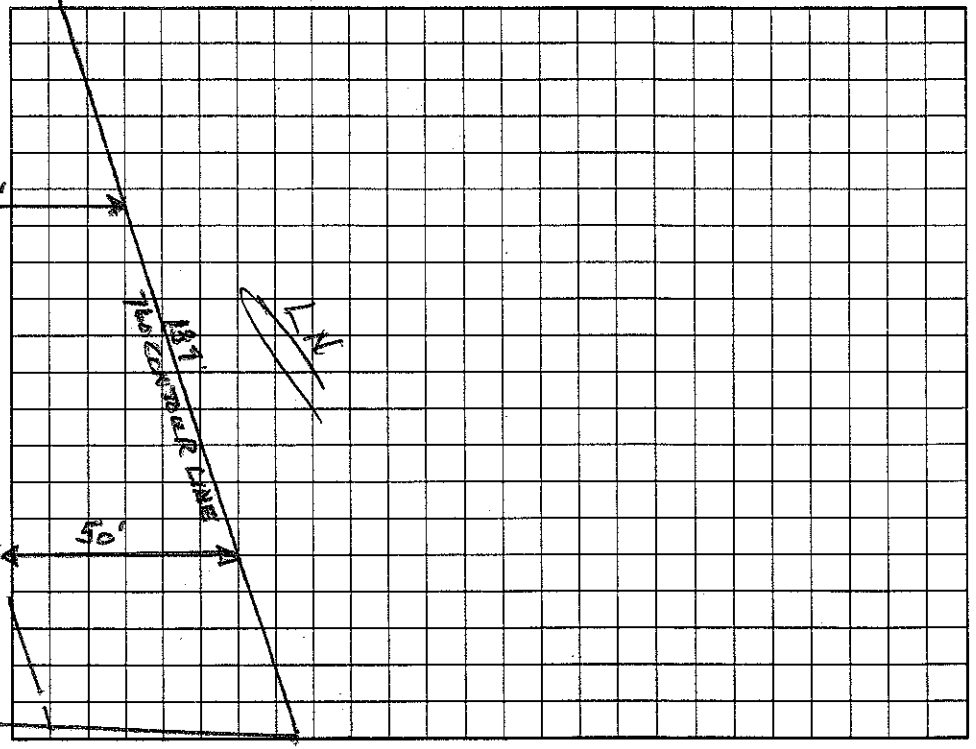

Permit can be suspended or revoked if any false information is supplied toward securing the permit/any unauthorized changes are made to the site/any unauthorized changes are made in the installation of the system. Improvement Permit with plat valid without expiration. Improvement Permit with site plan valid for sixty months. Authorization to Construct is valid for a period equal to that of Improvement Permit – not to exceed sixty months.

Signed: X [signature] date 6-6-2000 Installed by: Larry Beam

Improvement Permit by: Wesley Sparks RS date 6/6/00 Operation Permit by: Gary Mabry RSI date 7/20/00

Authorization to Construct by: Wesley Sparks RS. date 6/6/00 Existing System Inspection by: date

HEALTH DEPT. COPY: WHITE OWNER COPY (FINAL): YELLOW OWNER COPY (INITIAL): PINK