IREDELL COUNTY HEALTH DEPARTMENT

STATESVILLE 704-878-5305 MOORESVILLE 704-664-5281

IMPROVEMENT PERMIT / AUTHORIZATION TO CONSTRUCT / OPERATION PERMIT / EXISTING SYSTEM INSPECTION

PERMIT# 107910 PIN# 4636-84-0188 DATE 8/2/02

OWNER OR CONTRACTOR Kearney Const. Donald Sexton PHONE: Business 336-667-0700 Home

ADDRESS 1200 B Industrial Park Rd. Wilkesboro NC 28697

LOCATION Brawley Sch TL Canvasback, TR Spring Run, on Rt (211 Spring Run)

SUBDIVISION Mallard Head BLOCK / SECTION LOT 116 LOT AREA SITE CLASS. PS DESIGN FLOW 480 L.T.A.R. 0.3

Septic Tank: 1000 Gallons; STB 854 Date 7/16/02

Pump Tank: Gallons; PT Date

Pump Make: Model Serial No.

Nitrification Field: No Fields 1 Square Feet 1200 Linear Feet 400

No Lines 5@80' Trench Width 36" Max Trench Bottom Depth 36" Gravel Depth ~

☒ New System ☐ Repair System Type: I, II, III, IV, V, VI

System Description: Gravity 25% Red.

Repair System Description: LPP Panel Block

Maintenance Agreement Required: ☐ Yes ☒ No

☒ House/Mod. Home ☐ Mobile Home ☐ Business ☐ Other

No. Bedrooms 4 No. Bathrooms 3½ No. Employees

Water Supply: ☐ Individual ☐ Public ☒ Community


☐ Slab ☒ Crawl Space ☐ Basement w/plumbing ☐ Basement wo/plumbing

Comments:/Conditions:

Can Install Drop Boxes as Distribution Box

Comments:/Conditions:

INITIAL SITE SKETCH

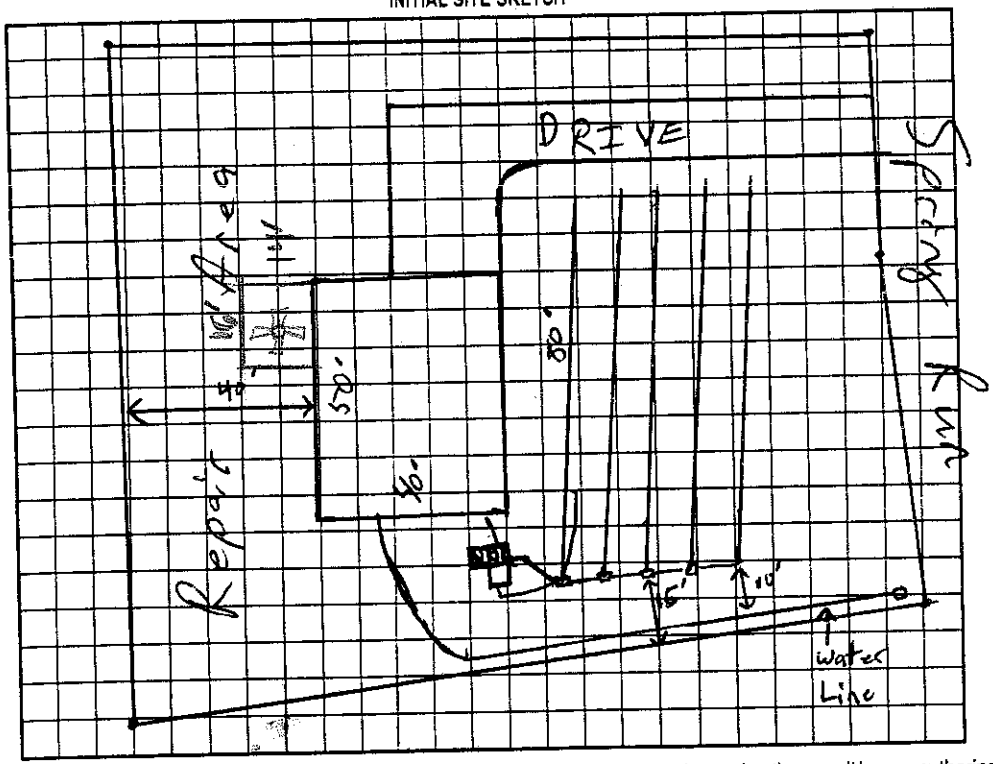

AS BUILT SKETCH

The proposed / existing Screen porch addition does not appear to impact the existing septic system.

**NOTE: Screened porch will be over exist deck.

Maria Dotson REHS

Date: 4/21/2010

ICHD-Environmental Health Division

Permit can be suspended or revoked if any false information is supplied toward securing the permit/any unauthorized changes are made to the site/any unauthorized changes are made in the installation of the system. Improvement Permit with plat valid without expiration. Improvement Permit with site plan valid for sixty months. Authorization to Construct is valid for a period equal to that of Improvement Permit – not to exceed sixty months.

Signed: John C Kearney date Installed by: Sterling Church

Improvement Permit by: RS date 8/2/02 Operation Permit by: Wesley Sparks RS date 5/2/03

Authorization to Construct by: RS date 8/2/02 Existing System Inspection by: date

HEALTH DEPT. COPY: WHITE OWNER COPY (FINAL): YELLOW OWNER COPY (INITIAL): PINK