IREDELL COUNTY HEALTH DEPARTMENT

Statesville Office (704) 878-5305 Mooresville Office (704) 660-3625 PERMIT # 213719

IMPROVEMENT PERMIT / AUTHORIZATION TO CONSTRUCT / OPERATION PERMIT / EXISTING SYSTEM

PIN # 4636840361

APPLICANT: Edgewater Pools/CB Hargrett APPLICANT ADDRESS: 9526 Henry Harris Rd. Fort Mill SC 29707

SITE ADDRESS: 205 Spring Run, Mooresville, NC 28117 PHONE: 704845-3065 ALT. PHONE: 704660-3988

SITE DIRECTIONS: Brawley School Rd TL Canvasback TR Spring Run ~.4 miles on right

SUBDIVISION: Mallard Head SECTION: 1 LOT # 117 LOT AREA: .46 Acre DESIGN FLOW: 360gpd L.T.A.R.: .3

Existing

Septic Tank 1000 (gal) STB Date

Pump Tank (gal) PT Date

Pump Make Model Serial #

Nitrification Fields 1 # Lines 4 @ 75' ea Linear Ft: 900'

Trench Width 36" Max. Trench Bottom Depth 36" Gravel Depth N/A

☐ New System ☒ Repair ☐ Expansion System Type: I II (III) IV V VI

System Description: Exist. Gravity - 25% Reduction

Repair System Description: Grav/Pump. Innovative

Maintenance Agreement Required: ☐ YES ☐ NO ☐ GRAVITY ☐ PRESSURE

☒ Residence No. Bedrooms 3

☐ Business No. Persons

☐ Other No. Employees

☐ Slab ☒ Crawl Space

☐ Basement w/plumbing ☐ Basement w/o plumbing

Water Supply

☐ Private


☒ Public

☒ Community

Comments / Conditions:

The proposed inground pool does not appear to impact the existing septic system.

INITIAL SITE SKETCH

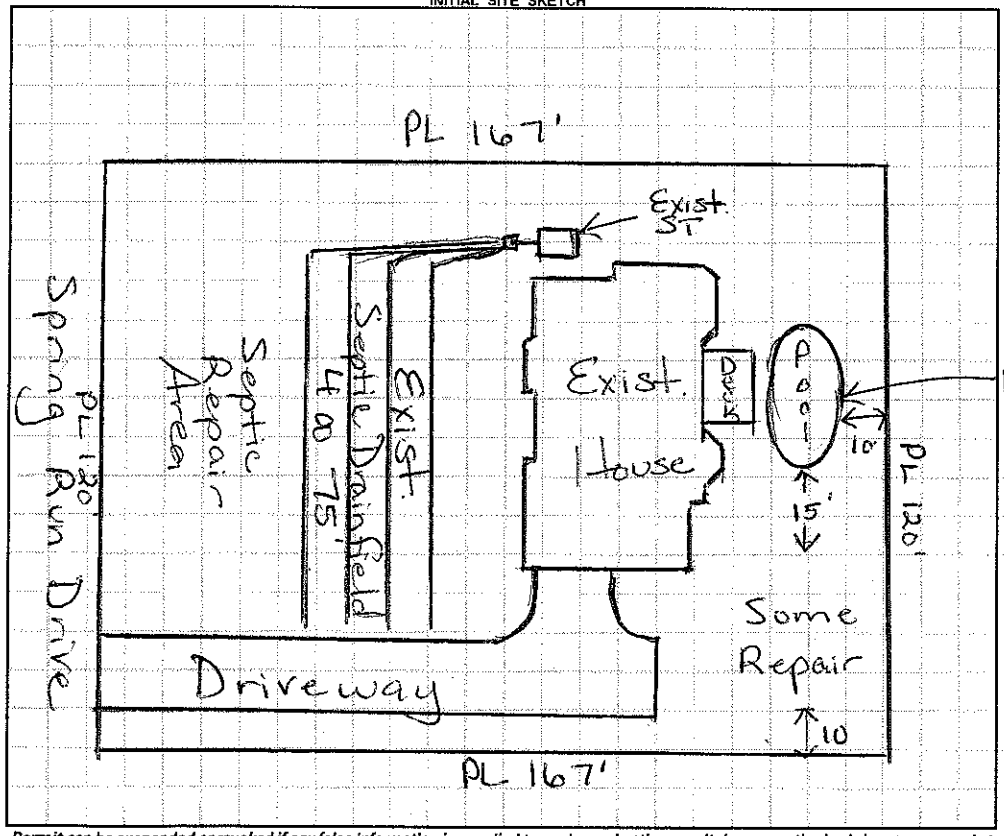

AS BUILT SKETCH

Permit can be suspended or revoked if any false information is supplied toward securing the permit / any unauthorized changes are made to the site / any unauthorized changes are made in the installation of the system. **CONTACT A LOCATOR SERVICE PRIOR TO ANY EXCAVATION**

☐ **IMPROVEMENT PERMIT** *with plat valid without expiration.* ☐ **IMPROVEMENT PERMIT** *with site plan valid for 60 mos.* ☐ **AUTHORIZATION TO CONSTRUCT** *valid for period equal to IMPROVEMENT PERMIT--not to exceed 60 mo.*

Owner / Applicant Signature: Date: 11/19/15 Installed by:

IMPROVEMENT PERMIT by: Date: OPERATION PERMIT by: Date:

AUTHORIZATION TO CONSTRUCT by: Date: Existing System Inspected by: Date: 11/3/15

Health Dept. Copy - WHITE Applicant (Final Approval) - YELLOW Applicant (Conditional Approval) - PINK