IREDELL COUNTY HEALTH DEPARTMENT

STATESVILLE 704-878-5305 130.00 Paid MOORESVILLE 704-664-5281 2:00-2:30

IMPROVEMENT PERMIT / AUTHORIZATION TO CONSTRUCT / OPERATION PERMIT / EXISTING SYSTEM INSPECTION

PERMIT# 117032 PIN# 4634840619 Sam Linker (Golf Course) DATE 6-11-04

OWNER OR CONTRACTOR Barbara Mauney/RYON WEST PHONE: Business 724-3779 Home (704) 398-0045

ADDRESS 225 Pine Island Dr Charlotte NC 28214

LOCATION Brawley School Rd TL Canvasback TR Spring Run lot on right #187

SUBDIVISION Mallard Head BLOCK / SECTION 120 LOT ____ LOT AREA .48Acre SITE CLASS. PS DESIGN FLOW 480gpd L.T.A.R. .25

Septic Tank: 1000 Gallons; STB 1007 Date 10-18-04
Pump Tank: 1000 Gallons; PT 274 Date 8-9-04
Pump Make: ____ Model ____ Serial No. ____
Nitrification Field: No Fields 1 Square Feet 1350' Linear Feet 450'
No Lines 5@90' Trench Width 36" Max Trench Bottom Depth 36" Gravel Depth N/A

☒ New System ☐ Repair System Type: I, II, III, IV, V, VI
System Description: Pump-25% Reduction
Repair System Description: Pump-Panel Block
Maintenance Agreement Required: ☐ Yes ☐ No


☒ House/Mod. Home No. Bedrooms 4
☐ Mobile Home No. Bathrooms 3
☐ Business No. Employees ____
☐ Other ____
☐ Slab ☒ Crawl Space ☐ Basement w/plumbing ☐ Basement wo/plumbing

Water Supply: ☐ Individual ☒ Public ☒ Community

Comments:/Conditions: Keep Septic System at least 10' from PL

Comments:/Conditions: Note: Septic System in Easement behind lot in only 5ft. From PL
Checked tanks & lines 11/17/04

INITIAL SITE SKETCH

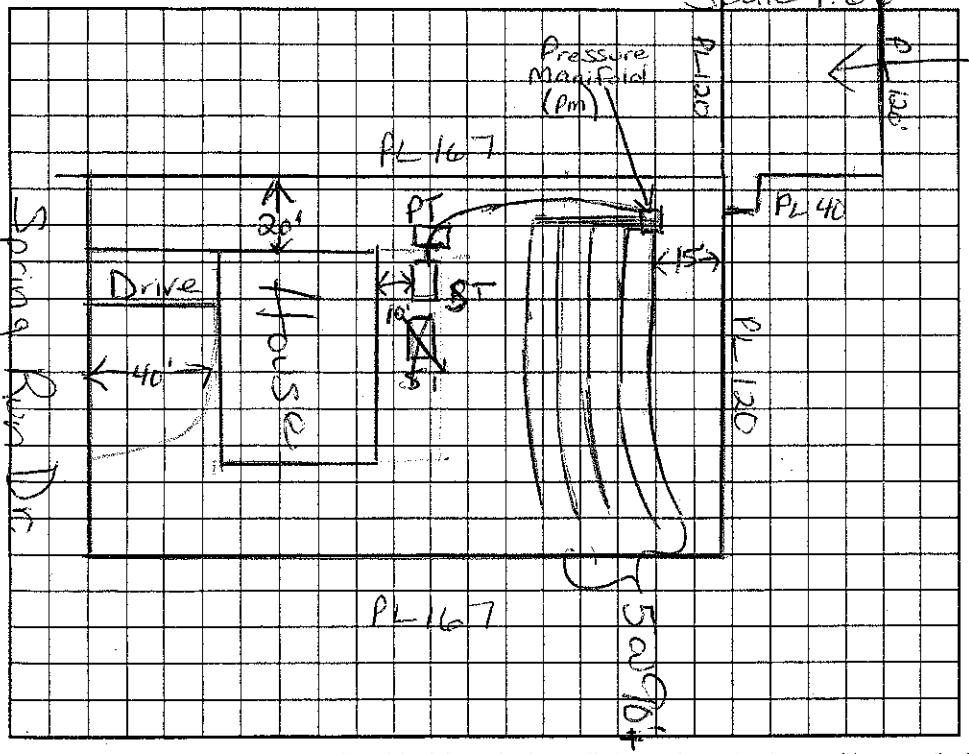

AS BUILT SKETCH

Repair
Septic Easement
for Lot 120

Installed as Drawn
Used 4" Plastic Chambers

Permit can be suspended or revoked if any false information is supplied toward securing the permit/any unauthorized changes are made to the site/any unauthorized changes are made in the installation of the system. Improvement Permit with plat valid without expiration. Improvement Permit with site plan valid for sixty months. Authorization to Construct is valid for a period equal to that of Improvement Permit – not to exceed sixty months.

Signed: Barbara B Mauney date 6/17/04 Installed by: Wayne Glontz (Jamie's Grading)

Improvement Permit by: Maria H. Dotson RS date 6/16/04 Operation Permit by: Maria H. Dotson RS date 1/28/05

Authorization to Construct by: Wesley Sparks RS. date 7/1/04 Existing System Inspection by: ____ date ____

HEALTH DEPT. COPY: WHITE OWNER COPY (FINAL): YELLOW OWNER COPY (INITIAL): PINK