9130-10:00

Authorization to Construct

IREDELL COUNTY HEALTH DEPARTMENT /

STATESVILLE 704-878-5305 MOORESVILLE 704-664-5281

IMPROVEMENT PERMIT / ~~CERTIFICATE OF COMPLETION~~ / OPERATION PERMIT / EXISTING SYSTEM INSPECTION

PROPERTY DESCRIPTION NO. 24337 DATE 9/27/96 TAX MAP NO. 2K 9A 122 4636840913 Watershed: ☒ Yes ☐ No

OWNER OR CONTRACTOR Stanley Martin c/o Tom Hunter PHONE: Business 664-5253 Home WIV CA

ADDRESS Spring Run Dr. Mooresville, NC 28115

LOCATION Spring Run Dr. - Brawley Sch. TL Canvasback TR Spring Run ~ .5 mile on (R)

SUBDIVISION Mallard Head BLOCK / SECTION 1 LOT 122 LOT AREA .5 AC SITE CLASS. PS DESIGN FLOW 360 L.T.A.R. .3

Septic Tank: 1000 Gallons; STB Country Slab 3/2 Date 7/30/00

Pump Tank: 1000 Gallons; PT 283 Date 6/27/00

Pump Make: Goulds 1/3 HP Model B00 0411 Serial No. W0311M

Nitrification Field: No Fields 1 Square Feet 1200 Linear Feet *300

No Lines 3 Trench Width 36 Max Trench Bottom Depth 32 Gravel Depth SAND

☒ New System ☐ Repair System Type: I, II, (III), IV, V, VI

System Description: PRES CH PLASTIC

Repair System Description: 16" PPBS

Maintenance Agreement Required: ☐ Yes ☒ No

☐ Slab ☒ Crawl Space ☐ Basement w/plumbing ☐ Basement wo/plumbing

☒ House/Mod. Home No. Bedrooms 3

☐ Mobile Home No. Bathrooms 2

☐ Business No. Employees

☐ Other


Water Supply: ☐ Individual ☒ Community ☐ Public

Comments: 135 gal per dose = 6.75 in drawdown
Pressure Manifold required
* Soil in trenches light in color


Comments: 1/4/00 - May locate house 40' from left side property line - AWS.
Filter was installed.
Tanks, lines & pressure checked. 9/7/00 MD

INITIAL SITE SKETCH

SPRING RUN DRIVE

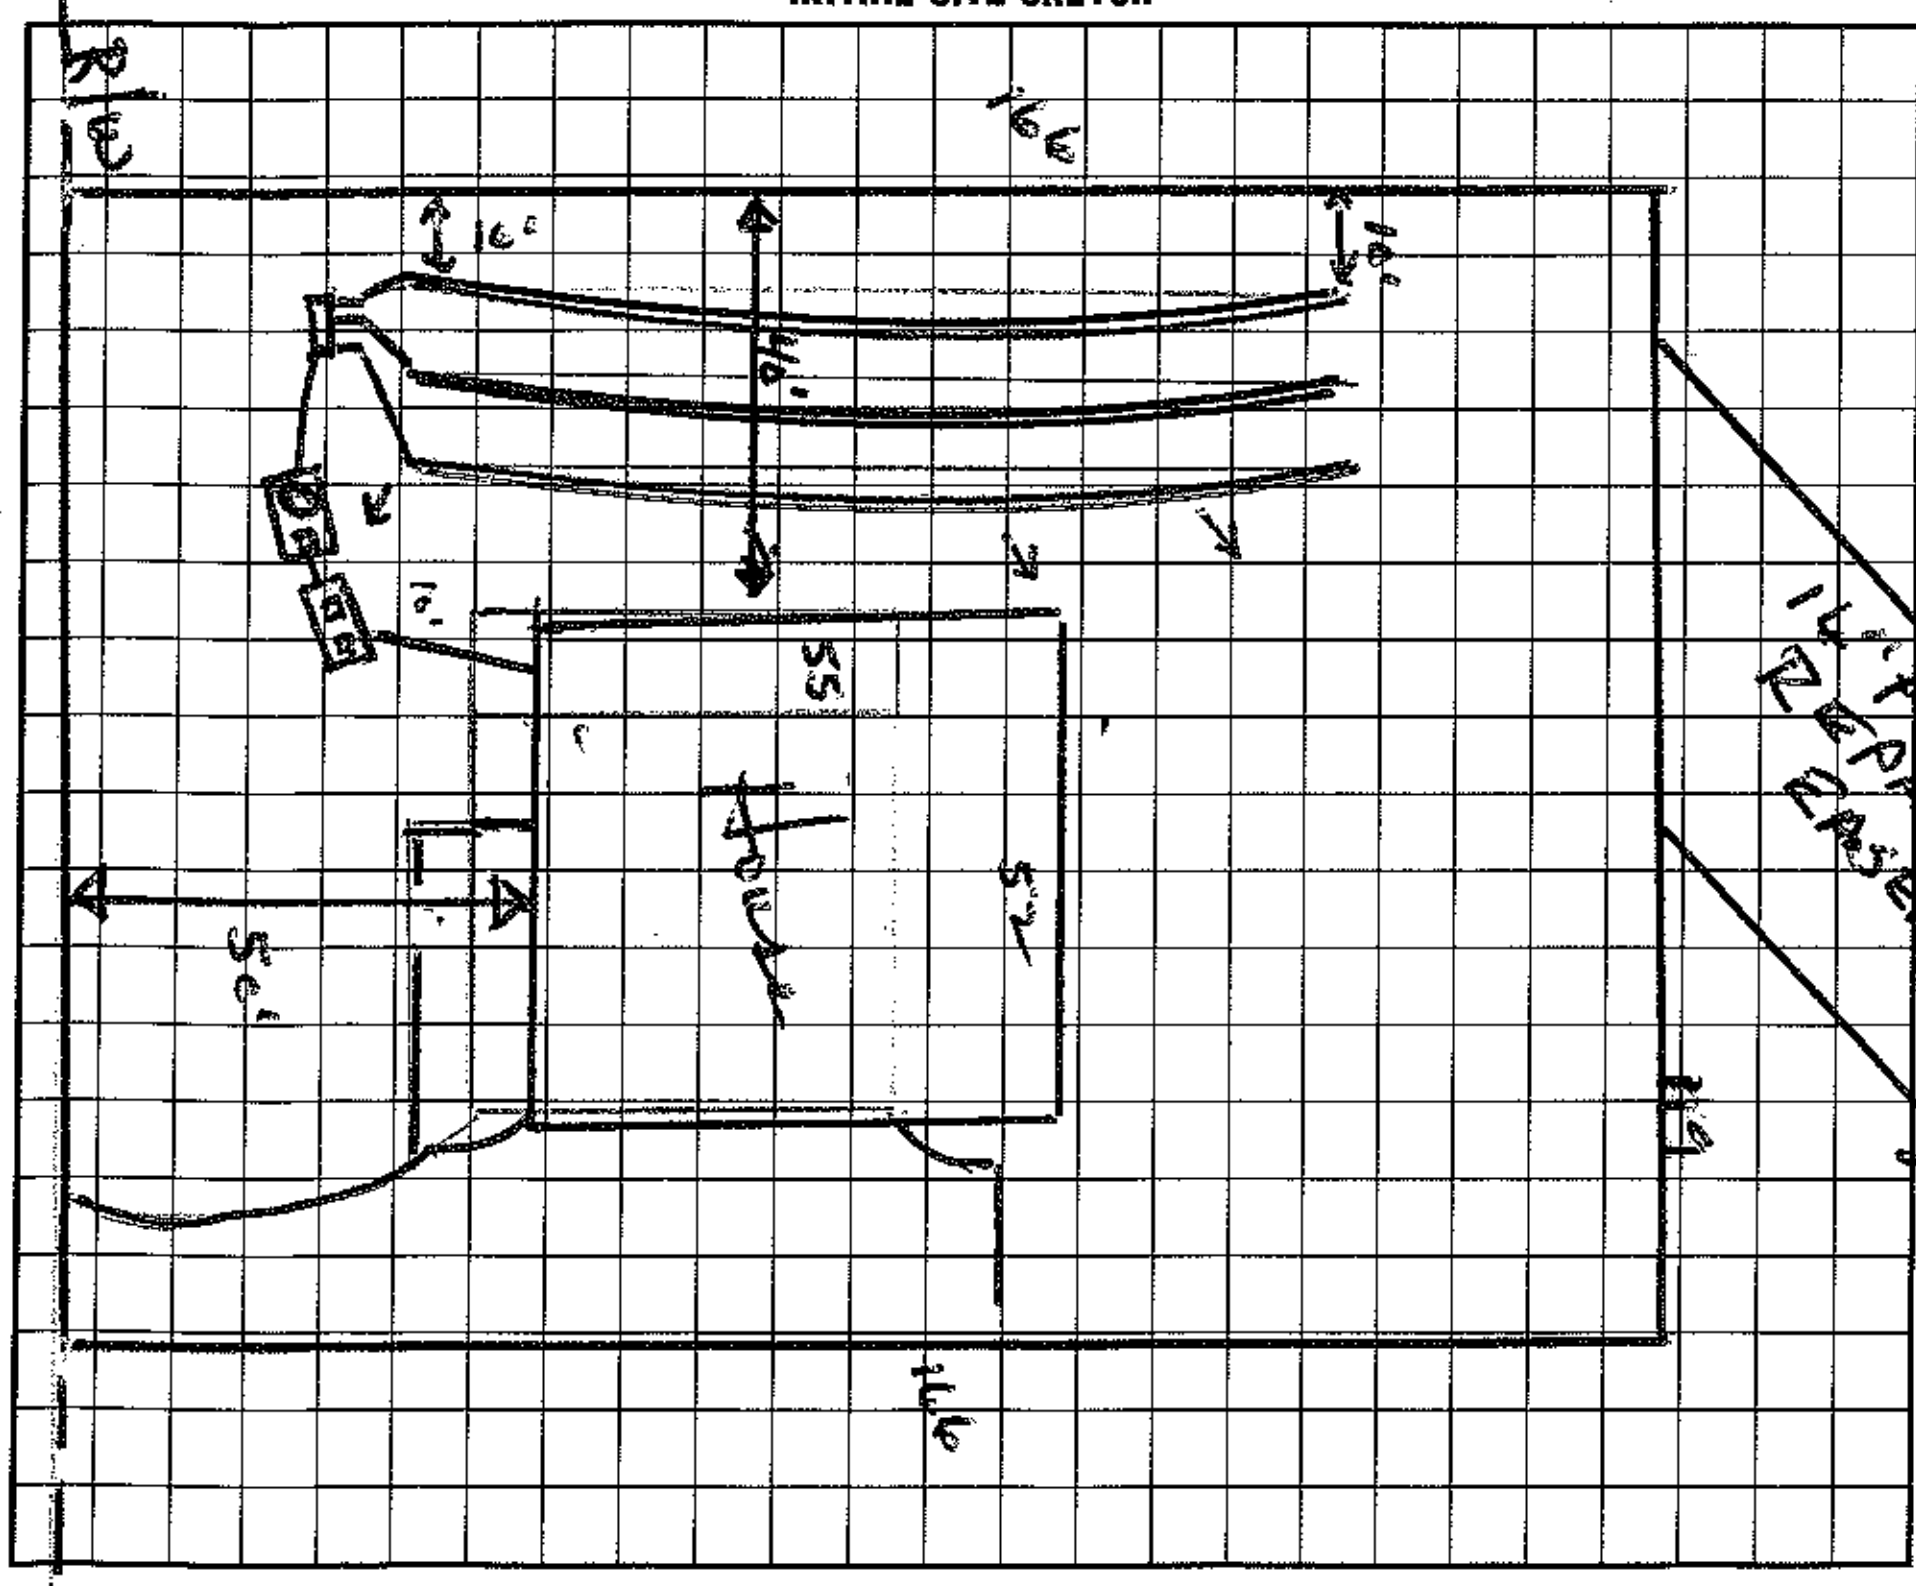

AS BUILT SKETCH

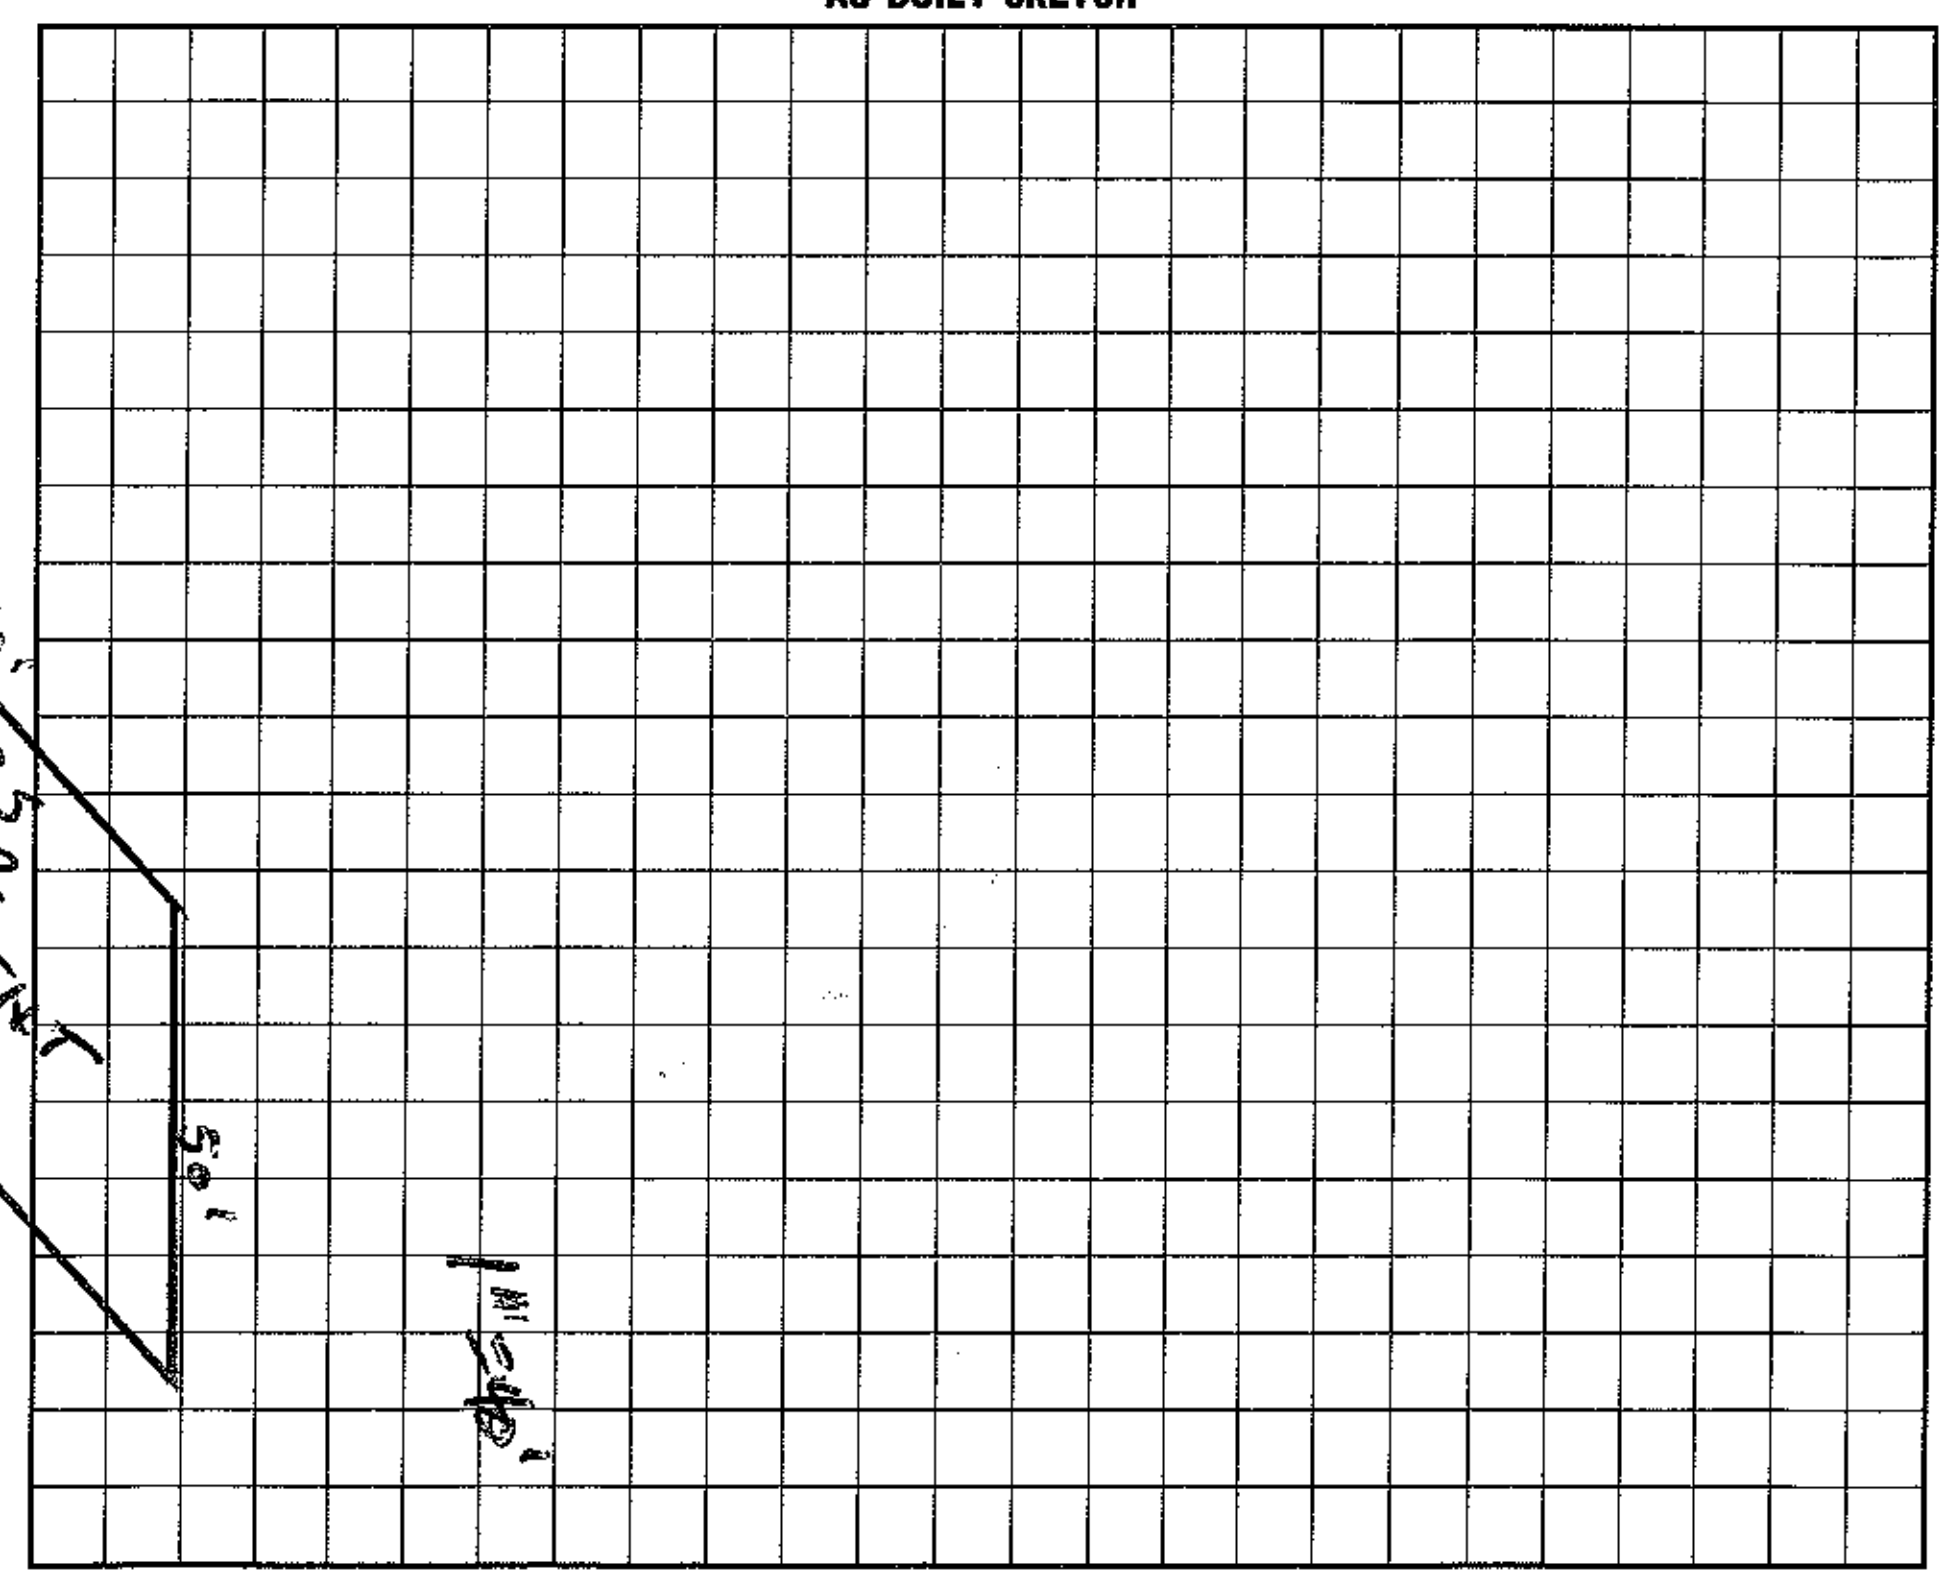

I understand that this permit can be suspended or revoked if any false information is supplied toward securing the permit/any unauthorized changes are made to the site/any unauthorized changes are made in the installation of the system.

Authorization to Construct valid 60 months.

Signed: * [signature]

Installed by: E & J Ervin

Improvement Permit by: Wesley Sparks RS. date 9/27/96

Certificate of Completion by: Marie H. Dotson RS date 10/30/00

Authorization to Construct ~~Existing System Inspection~~ by: Wesley Sparks RS. date 9/27/96

Operation Permit by: Marie H. Dotson RS date 10/30/00

HEALTH DEPT. COPY: WHITE INSPECTION COPY (FINAL): GREEN OWNER COPY (FINAL): YELLOW INSPECTION COPY (INITIAL): PINK OWNER COPY (INITIAL): GOLD