IREDELL COUNTY HEALTH DEPARTMENT

STATESVILLE 704-878-5305 MOORES

IMPROVEMENT PERMIT / CERTIFICATE OF COMPLETION / OPERATION PERMIT / EXISTING SYSTEM INSPECTION

PROPERTY DESCRIPTION NO. 16668 DATE July 16, '93 4636-89-4454 TAX MAP NO. 2K 9A 98&99

OWNER OR CONTRACTOR Bruce Buggs etux PHONE: Business 559-9056 Home

ADDRESS PO Box 16638 Charlotte NC 28297

LOCATION 1106 TL 1179 (Cowesbrook) on Right .4 1/10 mile past Broadbell

SUBDIVISION Walbert Heath BLOCK / SECTION LOT 98&99 LOT AREA 250 X ~150' SITE CLASS. 5 L.T.A.R. .3 gal/ft²/day

Water Supply: ☐ Individual ☑ Community ☐ Public

Septic Tank: 1000 Gallons; STB 358 ACP Date 11-17-93

Pump Tank: ____ Gallons; PT ____ Date ____

Nitrification Field: No Fields 1 Square Feet 810 Linear Feet 270

No Lines 2 Trench Width 36" Trench Depth 24-36" Gravel Depth 12"

☑ New System ☐ Repair System Type: I, II, III, IV, V

System Description: Gravity conventional

Repair System Description: ____

Maintenance Agreement Required: ☐ Yes ☑ No

☑ House/Mod. Home ☐ Mobile Home ☐ Business ☐ Other ____

No. Bedrooms 2 No. Bathrooms 2½ No. Employees ____

☐ Slab ☑ Crawl Space ☐ Basement w/plumbing

Garbage Disposal: ☑ Yes ☐ No


Auto. Dishwasher: ☑ Yes ☐ No

Auto. Washing Machine: ☑ Yes ☐ No

Other ____ ☐ Basement wo/plumbing

Comments ____

INITIAL SITE SKETCH

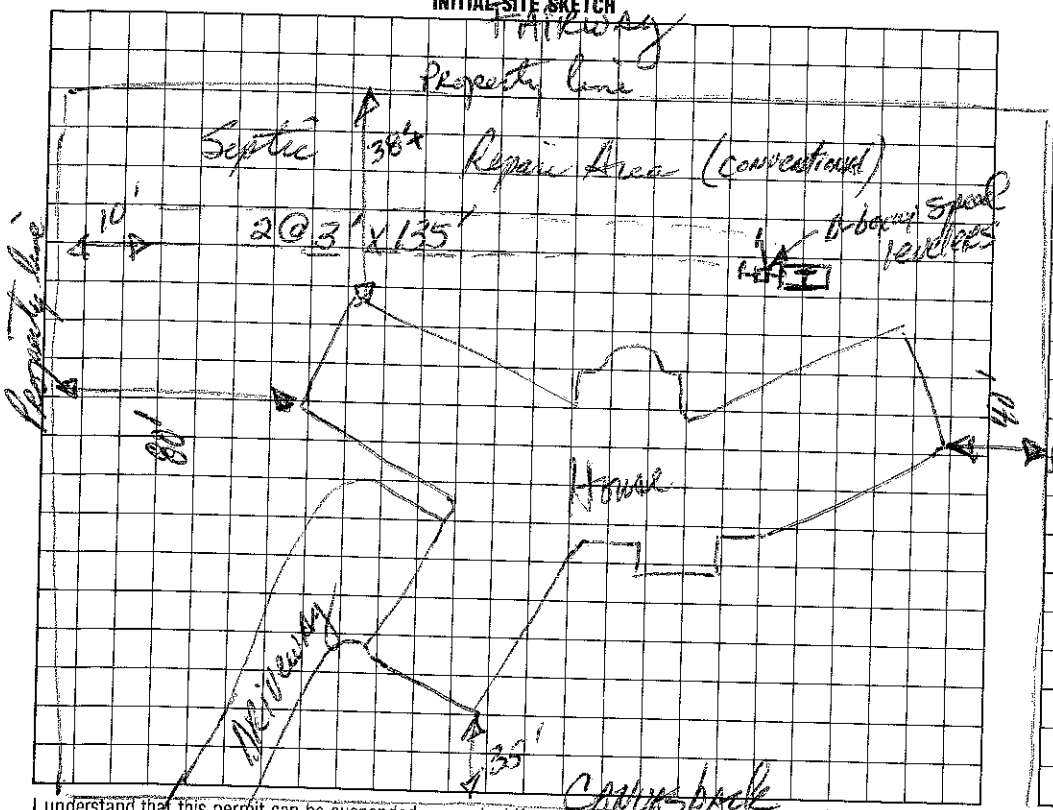

AS BUILT SKETCH

Essentially as shown on initial sketch

I understand that this permit can be suspended or revoked if any false information is supplied toward securing the permit/any unauthorized changes are made to the site/any unauthorized changes are made in the installation of the system. Improvement Permit is valid for 60 months from date of issuance.

Signed Bruce Buggs Jr. Bruce Buggs, Jr.

Improvement Permit by: Jarrell Truman RS date 7/16/93

Existing System Inspection by: ____ date ____

Installed by: Bruce Buggs, Jr.

Certificate of Completion by: Jarrell Truman, RS date Jan 21, '94

Operation Permit by: ____ date ____

HEALTH DEPT. COPY: WHITE INSPECTION COPY (FINAL): GREEN OWNER COPY (FINAL): YELLOW INSPECTION COPY (INITIAL): PINK OWNER COPY (INITIAL): GOLD