IREDELL COUNTY HEALTH DEPARTMENT

STATESVILLE 704-878-5305 MOORESVILLE 704-664-5281

10:30

IMPROVEMENT PERMIT / AUTHORIZATION TO CONSTRUCT / OPERATION PERMIT / EXISTING SYSTEM INSPECTION

PERMIT# N/A PIN# N/A 4636 84 4578

OWNER OR CONTRACTOR MIKE HOSIER PHONE: Business _____ DATE 4/30/98

ADDRESS 350 CANVASBACK - MOORESVILLE NC 28115 Home 660-0364

LOCATION BRAWLEY SCHOOL RD- TL CANVASBACK ~ ¾ MILE ON RT - # 350 CANVASBACK

SUBDIVISION MALLARD HEAD BLOCK / SECTION _____ LOT 97 LOT AREA 20,000 FT² SITE CLASS PS DESIGN FLOW 360 L.T.A.R. _____

Septic Tank: EXISTING Gallons; STB 744 Date 3-9-95

Pump Tank: 1000 Gallons; PT _____ Date _____

Pump Make: _____ Model _____ Serial No. _____

Nitrification Field: No Fields 1 Square Feet 765 Linear Feet 255

No Lines 3@85' Trench Width 36" Max Trench Bottom Depth 36" Gravel Depth N/A

☑ New System ☐ Repair System Type: I, II, (III), IV, V, VI

System Description: PUMP CHAMBERS OR HOS

Repair System Description: _____

Maintenance Agreement Required: ☐ Yes ☑ No

☑ House/Mod. Home No. Bedrooms 3

☐ Mobile Home No. Bathrooms 2

☐ Business No. Employees _____

☐ Other _____


☐ Slab ☑ Crawl Space ☐ Basement w/plumbing ☐ Basement wo/plumbing

Water Supply: ☐ Individual ☐ Public ☑ Community

Comments:/Conditions: ① OLD SYSTEM IS TO BE ABANDONED ② WHERE WATER LINE AND SUPPLY LINE CROSS - WATER LINE IS TO GO 18" ABOVE SEWER LINE ~~AND SEWER~~ OR SEWER LINE IS TO BE CONSTRUCTED OF DUCTILE IRON OR EQUIVALENT

Comments:/Conditions: ③ PLUMBING MAY BE CHANGED TO GRAVITY FEED SYSTEM IN FRONT. ④ SYSTEM WAS DESIGNED BECAUSE EXISTING SYSTEM WAS DAMAGED BY POOL COMPANY - DUE TO NO CONSULTATION BY THE HEALTH DEPT BEFORE INSTALLATION ⑤ SYSTEM REPLACEMENT.

INITIAL SITE SKETCH

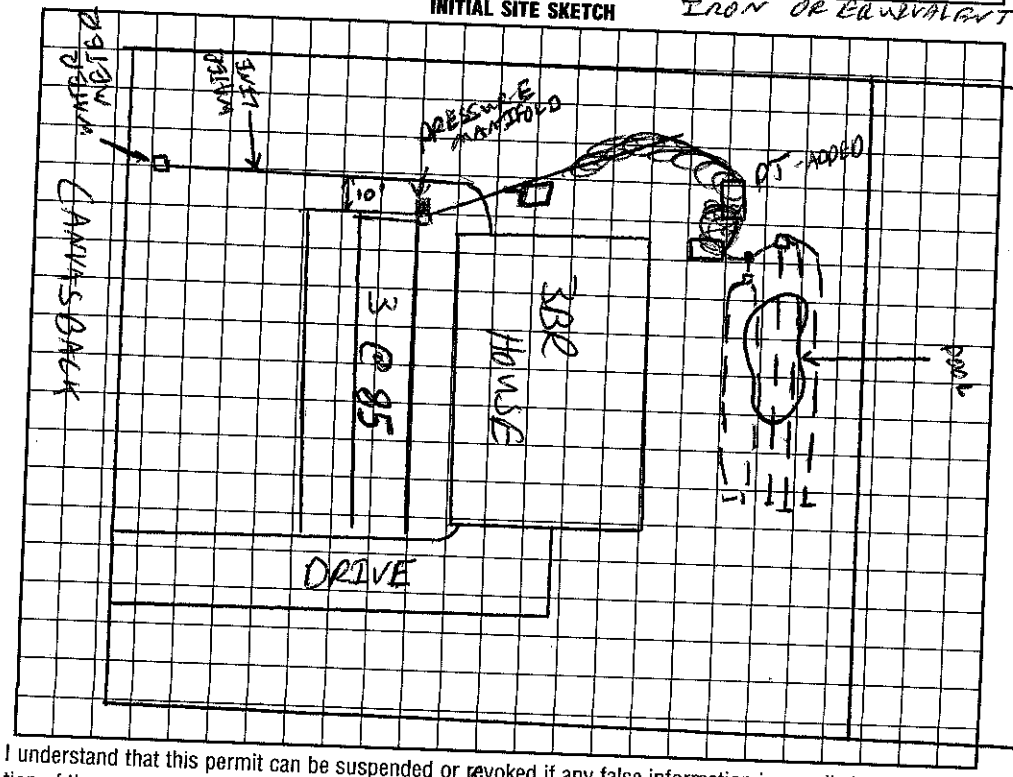

AS BUILT SKETCH

PLUMBING INSPECTED TO FRONT

I understand that this permit can be suspended or revoked if any false information is supplied toward securing the permit/any unauthorized changes are made to the site/any unauthorized changes are made in the installation of the system. Improvement Permit with plat valid without expiration. Improvement Permit with site plan valid for sixty months. Authorization to Construct is valid for a period equal to that of Improvement Permit – not to exceed sixty months.

Signed: Mike Hosier date 5/1/98

Improvement Permit by: C. Ky Teem RS date 4/30/98

Authorization to Construct by: C. Ky Teem RS date 4/30/98

Installed by: MAY HEW

Operation Permit by: _____ date _____

Existing System Inspection by: C. Ky Teem date 5/14/98

HEALTH DEPT. COPY: WHITE INSPECTION COPY (FINAL): GREEN OWNER COPY (FINAL): YELLOW INSPECTION COPY (INITIAL): PINK OWNER COPY (INITIAL): GOLD