IREDELL COUNTY HEALTH DEPARTMENT

STATESVILLE 704-878-5305 / 30.00 Paid MOORESVILLE 704-664-5281

2 3rd

IMPROVEMENT PERMIT / AUTHORIZATION TO CONSTRUCT / OPERATION PERMIT / EXISTING SYSTEM INSPECTION

PERMIT# 111678 PIN# 4636-84-5701 DATE 4/3/03

OWNER OR CONTRACTOR EFC Associates PHONE: Business 704 664-8047 Home

ADDRESS 101 Castles Gate Dr. Mooresville NC 28117 (344 Canvasback Rd.)

LOCATION Brawley Sch, TL Canvasback on Rt past Broad Bill #344

SUBDIVISION Mallard Head BLOCK / SECTION LOT 96 LOT AREA 0.47 SITE CLASS. PS DESIGN FLOW 360 L.T.A.R. 0.3

Septic Tank: 1000 Gallons; STB 312 Date 4/8/02

Pump Tank: Gallons; PT Date

Pump Make: Model Serial No.

Nitrification Field: No Fields 1 Square Feet 900 Linear Feet 300

No Lines 3@100' Trench Width 36" Max Trench Bottom Depth 36" Gravel Depth —

☒ New System ☐ Repair System Type: I, II, (III), IV, V, VI

System Description: Gravity 25% Reduct.

Repair System Description: Pump Panel Block

Maintenance Agreement Required: ☐ Yes ☒ No

☒ House/Mod. Home No. Bedrooms 3

☐ Mobile Home No. Bathrooms 2½

☐ Business No. Employees

☐ Other


☐ Slab ☒ Crawl Space ☐ Basement w/plumbing ☐ Basement wo/plumbing

Water Supply: ☐ Individual ☐ Public ☒ Community

Comments:/Conditions: 4 at 75' installed Infiltrator

Comments:/Conditions:

INITIAL SITE SKETCH

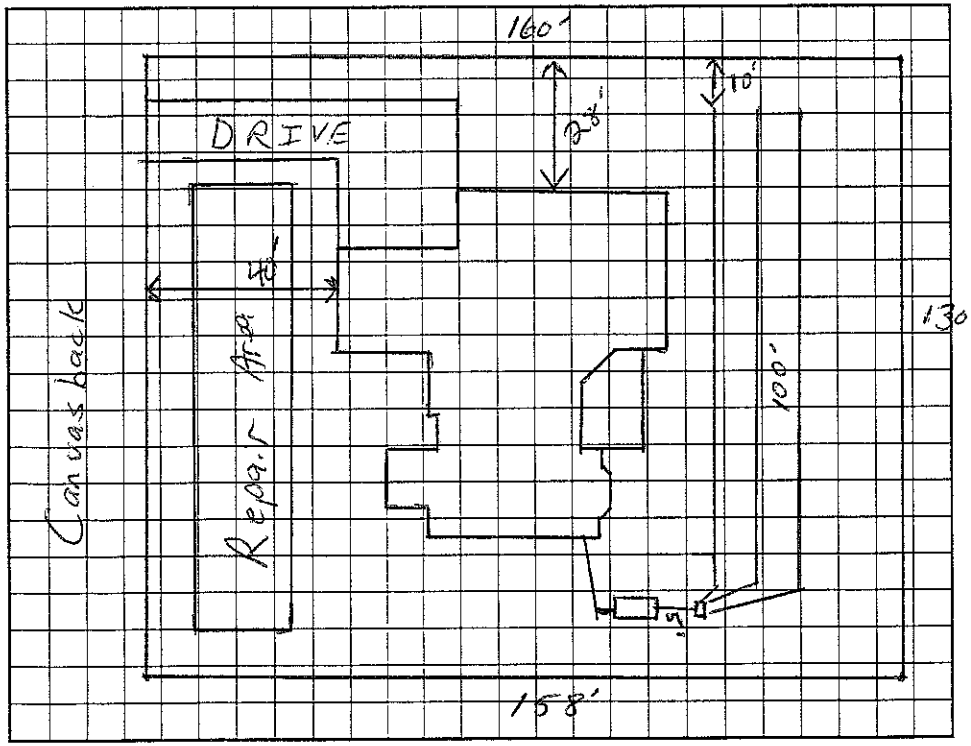

AS BUILT SKETCH

Permit can be suspended or revoked if any false information is supplied toward securing the permit/any unauthorized changes are made to the site/any unauthorized changes are made in the installation of the system. Improvement Permit with plat valid without expiration. Improvement Permit with site plan valid for sixty months. Authorization to Construct is valid for a period equal to that of Improvement Permit – not to exceed sixty months.

Signed: DM Beaver date 4-7-03

Improvement Permit by: RS date 4/3/03

Authorization to Construct by: RS date 4/3/03

Installed by: Upright Grading

Operation Permit by: Wesley Sparks R.S. date 9/11/03

Existing System Inspection by: date

HEALTH DEPT. COPY: WHITE OWNER COPY (FINAL): YELLOW OWNER COPY (INITIAL): PINK