IREDELL COUNTY HEALTH DEPARTMENT

Authorization to Construct

STATESVILLE 704-878-5305 MOORESVILLE 704-664-5281

3rd

IMPROVEMENT PERMIT / ~~CERTIFICATE OF COMPLETION~~ / OPERATION PERMIT / EXISTING SYSTEM INSPECTION

PROPERTY DESCRIPTION NO. 069380 DATE 10/20/97 TAX MAP NO. 4636845843 Watershed: X Yes ☐ No

OWNER OR CONTRACTOR Darren McRorie PHONE: Business _____ Home 896-2630

ADDRESS 21123 Torrence Chapel Rd Cornelius, NC. 28031

LOCATION Brawley Sch TL Cannon Back on (R) past Bayfield

SUBDIVISION MALLARD HEAD BLOCK / SECTION _____ LOT 95 LOT AREA 1.45 Ac SITE CLASS. PS DESIGN FLOW 360 L.T.A.R. .3

Septic Tank: 1000 Gallons; STB 794 Date 10/22/97

Pump Tank: _____ Gallons; PT _____ Date _____

Pump Make: _____ Model 900 Serial No. 300 Acc

Nitrification Field: No Fields 1 Square Feet ~~1000~~ Linear Feet ~~400~~

No Lines 4 Trench Width 36" Max Trench Bottom Depth 36" Gravel Depth 12"

X New System ☐ Repair System Type: I, (II), III, IV, V, VI

System Description: GRAV - CONVENTIONAL

Repair System Description: 16" Prefab Panel Block

Maintenance Agreement Required: ☐ Yes X No

X House/Mod. Home No. Bedrooms 3

☐ Mobile Home No. Bathrooms 2.5

☐ Business No. Employees _____

☐ Other _____


☐ Slab X Crawl Space ☐ Basement w/plumbing ☐ Basement wo/plumbing

Water Supply: ☐ Individual X Community ☐ Public


Comments: 3/4/98 - Mayes Ch. Plastic in same area on lot. Acc.

Comments:

INITIAL SITE SKETCH 1" = 40'

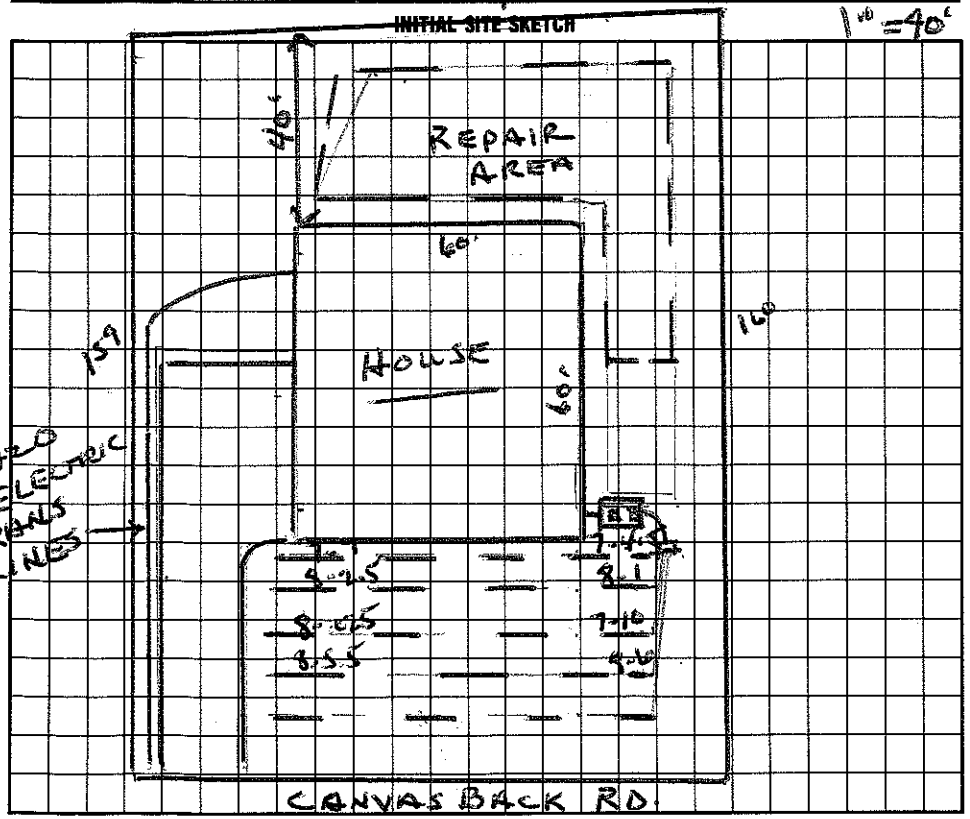

AS BUILT SKETCH

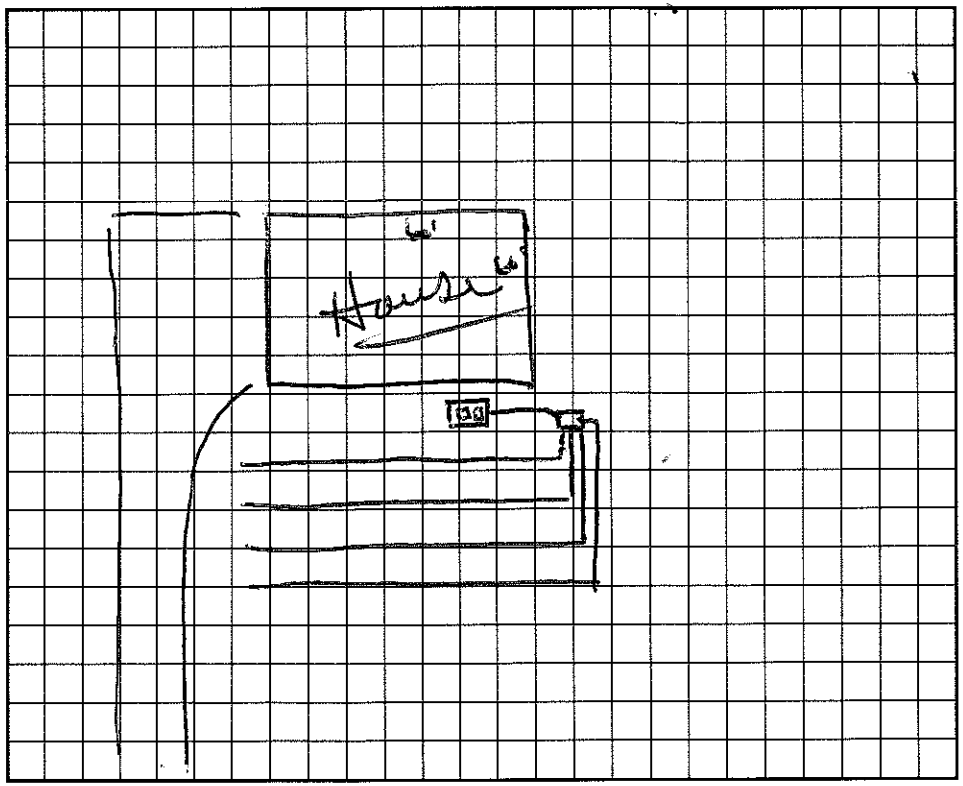

I understand that this permit can be suspended or revoked if any false information is supplied toward securing the permit/any unauthorized changes are made to the site/any unauthorized changes are made in the installation of the system. Improvement Permit is valid for 60 months from date of issuance.

Signed: X [signature]

Improvement Permit by: Wesley Sparks R.S. date 10/20/97

Existing System Inspection by: Wesley Sparks R.S. date 10/20/97

Installed by: Tim Cannon

Certificate of Completion by: Wesley Sparks R.S. date 3/5/98

Operation Permit by: Wesley Sparks R.S. date 3/5/98

HEALTH DEPT. COPY: WHITE INSPECTION COPY (FINAL): GREEN OWNER COPY (FINAL): YELLOW INSPECTION COPY (INITIAL): PINK OWNER COPY (INITIAL): GOLD