IREDELL COUNTY HEALTH DEPARTMENT

Statesville Office (704) 878-5305 Mooresville Office (704) 660-3625

PERMIT # 219016

IMPROVEMENT PERMIT / AUTHORIZATION TO CONSTRUCT / OPERATION PERMIT / EXISTING SYSTEM

PIN # 4636546276 ✓

APPLICANT: Kelly Watson APPLICANT ADDRESS: 359 Canvasback Rd Mooresville NC

SITE ADDRESS: ✓359 Canvasback Rd Mooresville NC PHONE: 704-660-1463 ALT. PHONE: 469-628-8535


SITE DIRECTIONS: Brawley School Rd T/L Canvasback Lot on left past broadhill

SUBDIVISION: Woodland Hills SECTION: 9 LOT # 121 LOT AREA: 1.12 ac DESIGN FLOW: 360 L.T.A.R.: Ex


Septic Tank	Ex (gal)	STB	Date	☐ New System ☐ Repair ☐ Expansion System Type: I II III IV V VI		☒ Residence	No. Bedrooms	3	Water Supply	
Pump Tank	(gal)	PT	Date	System Description: Existing		☐ Business	No. Persons	6	☐ Private	
Pump Make	Model		Serial #	Repair System Description:		☐ Other	No. Employees		☒ Public	
# Nitrification Fields	Ex # Lines	Ex	Linear Ft: Ex	Maintenance Agreement Required: ☐ YES ☒ NO		☐ Slab	☒ Crawl Space		☒ Community	
Trench Width	Ex Max. Trench Bottom Depth	Ex	Gravel Depth	☒ GRAVITY ☐ PRESSURE		☐ Basement w/plumbing			☐ Basement w/o plumbing	

Comments / Conditions: Maintain 15' from any part of STS with hot tub

INITIAL SITE SKETCH

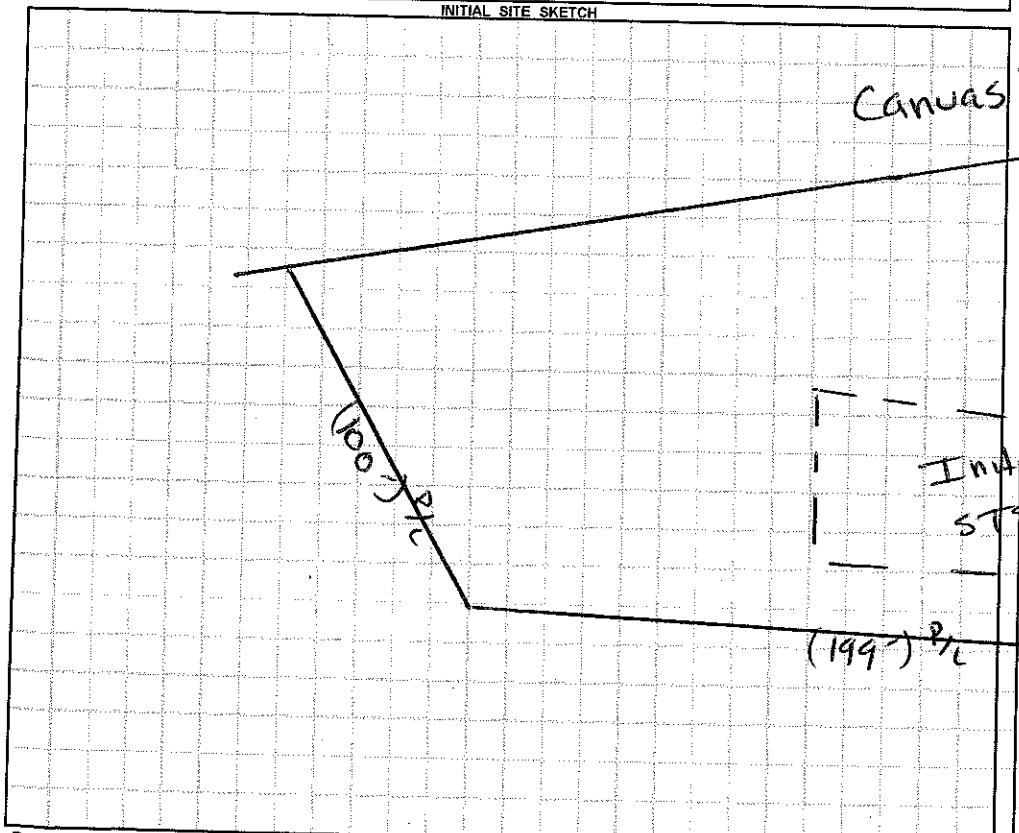

AS BUILT SKETCH

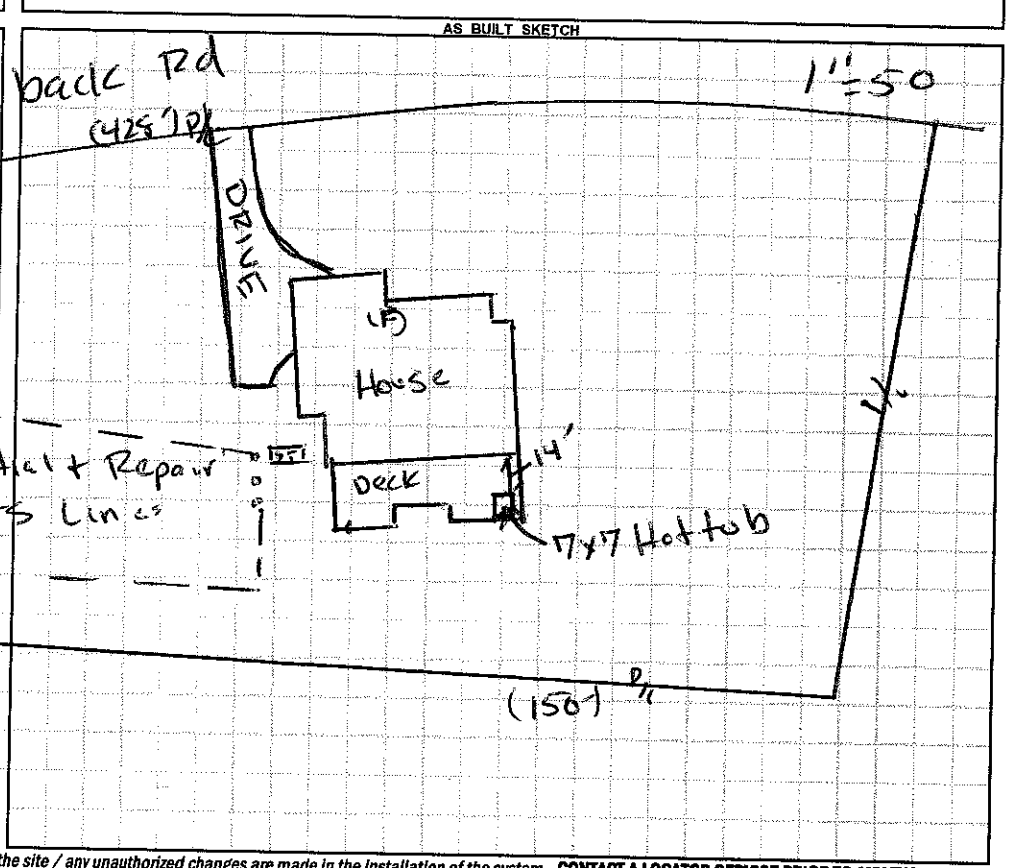

Permit can be suspended or revoked if any false information is supplied toward securing the permit / any unauthorized changes are made to the site / any unauthorized changes are made in the installation of the system. **CONTACT A LOCATOR SERVICE PRIOR TO ANY EXCAVATION**

☐ **IMPROVEMENT PERMIT** ***with plat*** *valid without expiration.* ☐ **IMPROVEMENT PERMIT** ***with site plan*** *valid for 60 mos.* ☐ **AUTHORIZATION TO CONSTRUCT** *valid for period equal to IMPROVEMENT PERMIT--not to exceed 60 mo.*

Owner / Applicant Signature: _____ Date: 8-26-16 Installed by: _____

IMPROVEMENT PERMIT by: _____ Date: _____ OPERATION PERMIT by: _____ Date: _____

AUTHORIZATION TO CONSTRUCT by: _____ Date: _____ Existing System Inspected by: _____ Date: 08/11/16

Health Dept. Copy - WHITE Applicant (Final Approval) - YELLOW Applicant (Conditional Approval) - PINK