IREDELL COUNTY HEALTH DEPARTMENT

Statesville Office (704) 878-5305 Mooresville Office (704) 660-3625 PERMIT # 14702 1 ✓

IMPROVEMENT PERMIT / AUTHORIZATION TO CONSTRUCT / OPERATION PERMIT / EXISTING SYSTEM

PIN # 4636 847 842

APPLICANT: Doug Dupler APPLICANT ADDRESS:

SITE ADDRESS: 341 Canvasback Mooresville NC 28117 PHONE: 980 275-9630 ALT. PHONE:

SITE DIRECTIONS: Brawley School Rd TL Canvasback on left just past Broadbill Rd ~1.5 miles on left

SUBDIVISION: Woodland Hills SECTION: LOT # 119 LOT AREA: .78 Acre DESIGN FLOW: 360gpd L.T.A.R.: .3

Septic Tank	1000 (gal)	STB	794	Date	4/16/14	☒ New System ☐ Repair ☐ Expansion	System Type: I II III IV V VI	☒ Residence	No. Bedrooms 3
Pump Tank	1000 (gal)	PT	288	Date	8/28/96	System Description: LP - PPBPS		☐ Business	No. Persons 6
Pump Make	HYDROMATIC	Model	3HF45M2	Serial #	936154	Repair System Description: Same		☐ Other	No. Employees
# Nitrification Fields	1	# Lines	5	Linear Ft:	200ft	Maintenance Agreement Required: ☒ YES ☐ NO		☐ Slab	☐ Crawl Space
Trench Width	24"	Max. Trench Bottom Depth	30"	Gravel Depth	N/A	☐ GRAVITY ☒ PRESSURE		☒ Basement w/plumbing	☐ Basement w/o plumbing

Water Supply: ☐ Private ☐ Public ☒ Community

Comments / Conditions: This permit replaces previous permit dated 12/28/07
Use In line filter in PT

★ Divert stormwater away from Septic System

INITIAL SITE SKETCH

See Attached/approved plan by Soil & Forestry Services (W. Overby LSS) dated 7/3/14

AS BUILT SKETCH

DRAINFIELD 10/29/14
& TANKS OK SL

SUPPLY LINE OK 10/29/14
SL

SET 2' PM
RA

APPROVED NOV 06 2014

Permit can be suspended or revoked if any false information is supplied toward securing the permit / any unauthorized changes are made to the site / any unauthorized changes are made in the installation of the system. **CONTACT A LOCATOR SERVICE PRIOR TO ANY EXCAVATION**

☐ **IMPROVEMENT PERMIT** *with plat valid without expiration.* ☒ **IMPROVEMENT PERMIT** *with site plan valid for 60 mos.* ☒ **AUTHORIZATION TO CONSTRUCT** *valid for period equal to IMPROVEMENT PERMIT--not to exceed 60 mo.*

Owner / Applicant Signature: Date: 7/3/14

IMPROVEMENT PERMIT by: Date: 7/3/14

AUTHORIZATION TO CONSTRUCT by: Date: 7/3/14

Installed by: LARRY HINKLE

OPERATION PERMIT by: Date: APPROVED NOV 07 2014

Existing System Inspected by: Date:

Health Dept. Copy - WHITE Applicant (Final Approval) - YELLOW Applicant (Conditional Approval) - PINK

NOTES:

* PROPERTY MAY BE SUBJECT TO RECORDED OR UNRECORDED RIGHTS OF WAYS OR EASEMENTS NOT OBSERVED
* OWNER TO VERIFY ALL SETBACKS AND ZONING REGULATIONS PRIOR TO ANY PLANNING OR CONSTRUCTION.
* DIMENSIONS OF ALL IMPROVEMENTS SHOWN ON THIS PLAT SHOULD NOT BE SCALED OR RELIED UPON FOR DESIGN OR CONSTRUCTION WITHOUT A FIELD VERIFICATION OF ALL DIMENSIONS.
* DIGITAL COPIES OF THIS FILE ARE FOR REFERENCE ONLY AND MAY NOT BE USED FOR DESIGN WORK.
* 10' DRAIN. & UTILITY EASEMENT MAY EXIST ALONG EACH LOT LINE.
* NO USGS MONUMENT FOUND WITHIN 2000' OF SUBJECT PROPERTY.
* THIS PROPERTY IS NOT LOCATED IN A 100 YEAR FLOOD PLAIN.

Curve	Radius	Length	Chord	Chord Bear.
C1	3709.84'	99.10'	99.10'	N 14°06'35" E

LEGEND:


- BOUNDARY LINE
- SANITARY SEWER LINE
- NATURAL GAS LINE
- UNDERGROUND POWER
- OVERHEAD UTILITIES
- UNDERGROUND TELEPHONE
- WATER LINE
- FENCE (TYPE NOTED)

CP = COMPUTED POINT (UNMARKED)
R/W = RIGHT-OF-WAY
E/P = EDGE OF PAVEMENT
C/L = CENTERLINE
= UTILITY POLE

DEDMON SURVEYS

40 0 40 80 120

GRAPHIC SCALE - FEET

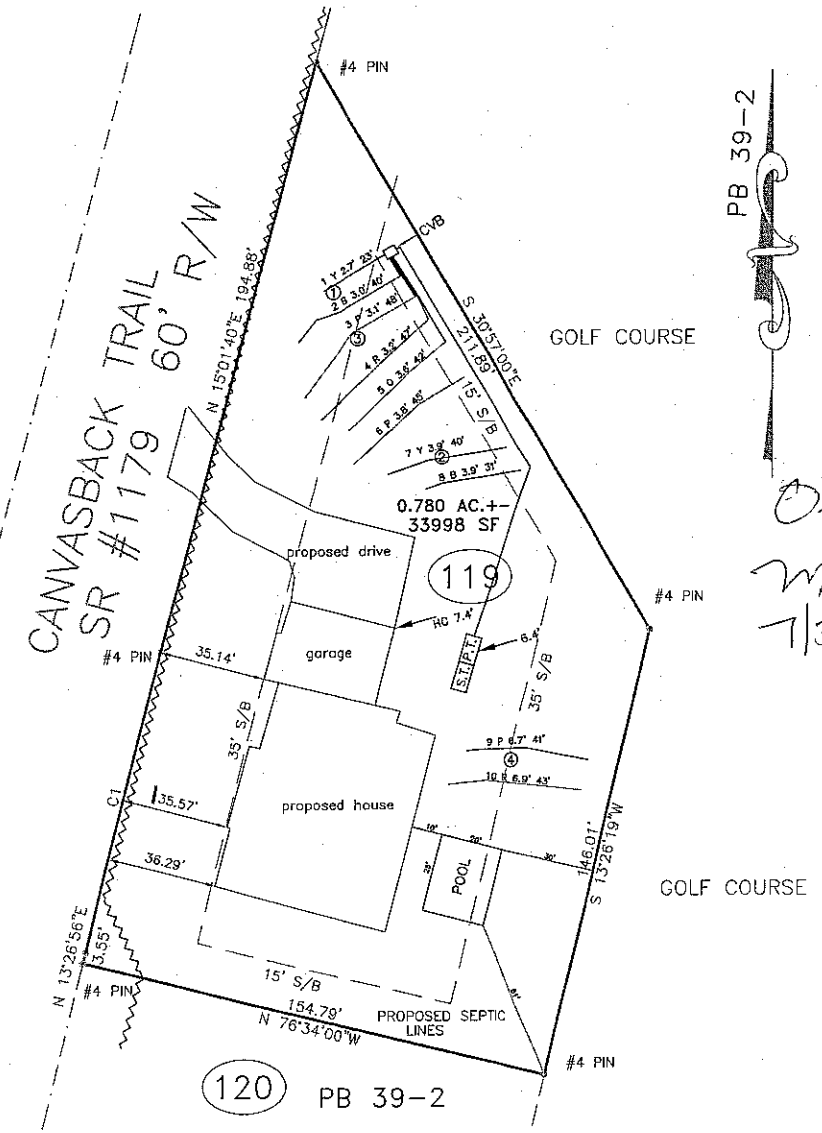

PB 39-2

OK

7/3/14

PHYSICAL SURVEY
FOR

DOUG DUPLER

LOT #119 WOODLAND HILLS

DATE: 5-23-14 DB: 1960 PG: 699
DB: PG:
40' PB: 39 PG: 2

DAVIDSON TOWNSHIP
IREDELL COUNTY, NC

DEDMON SURVEYS

CHUCK POOVEY, PLS #3762
ROBERT DEDMON, PLS #3899

3704 NC HIGHWAY #16 BUSINESS NORTH
P.O. BOX 494 - DENVER, NC 28037
PHONE: 704/483/4908
FAX: 704/483/2170

NORTH CAROLINA PROFESSIONAL SEAL L-3762 LAND SURVEYOR CHUCK POOVEY

VICINITY MAP

