IREDELL COUNTY HEALTH DEPARTMENT

Authorization to Construct

STATESVILLE 704-878-5305 MOORESVILLE 704-664-5281

IMPROVEMENT PERMIT / ~~CERTIFICATE OF COMPLETION~~ / OPERATION PERMIT / EXISTING SYSTEM INSPECTION

PROPERTY DESCRIPTION NO. 24226 DATE 7/18/96 TAX MAP NO. 2K 9 A 60 Watershed: [X] Yes [ ] No

OWNER OR CONTRACTOR Emily Bumgenener PHONE-Business 4636-85-4237 Home 896-1635

ADDRESS 835 Beatty St Apt A-11 Davidson, NC 28036

LOCATION Billy Joe Rd; Blue Sch TL Conover Lynch TL BJ Rd. to end.

SUBDIVISION Mallard Head BLOCK / SECTION ____ LOT 60 LOT AREA ____ SITE CLASS. PS DESIGN FLOW 360 L.T.A.R. .3

Septic Tank: 1000 Gallons; STB 1012 Date 11/9/96

Pump Tank: ____ Gallons; PT ____ Date ____

Pump Make: ____ Model ____ Serial No. ____

Nitrification Field: No Fields 1 Square Feet 1200 Linear Feet 400

No Lines 5 Trench Width 36" Max Trench Bottom Depth 36" Gravel Depth 12"

[X] New System [ ] Repair System Type: I, [II] III, IV, V, VI

System Description: CONV

Repair System Description: CH PLASTIC

Maintenance Agreement Required: [ ] Yes [X] No

[X] House/Mod. Home No. Bedrooms 3

[ ] Mobile Home No. Bathrooms 2

[ ] Business No. Employees ____

[ ] Other ____


[ ] Slab [ ] Crawl Space [ ] Basement w/plumbing [ ] Basement wo/plumbing

Water Supply: [ ] Individual [X] Community [ ] Public


Comments:

Comments:

INITIAL SITE SKETCH

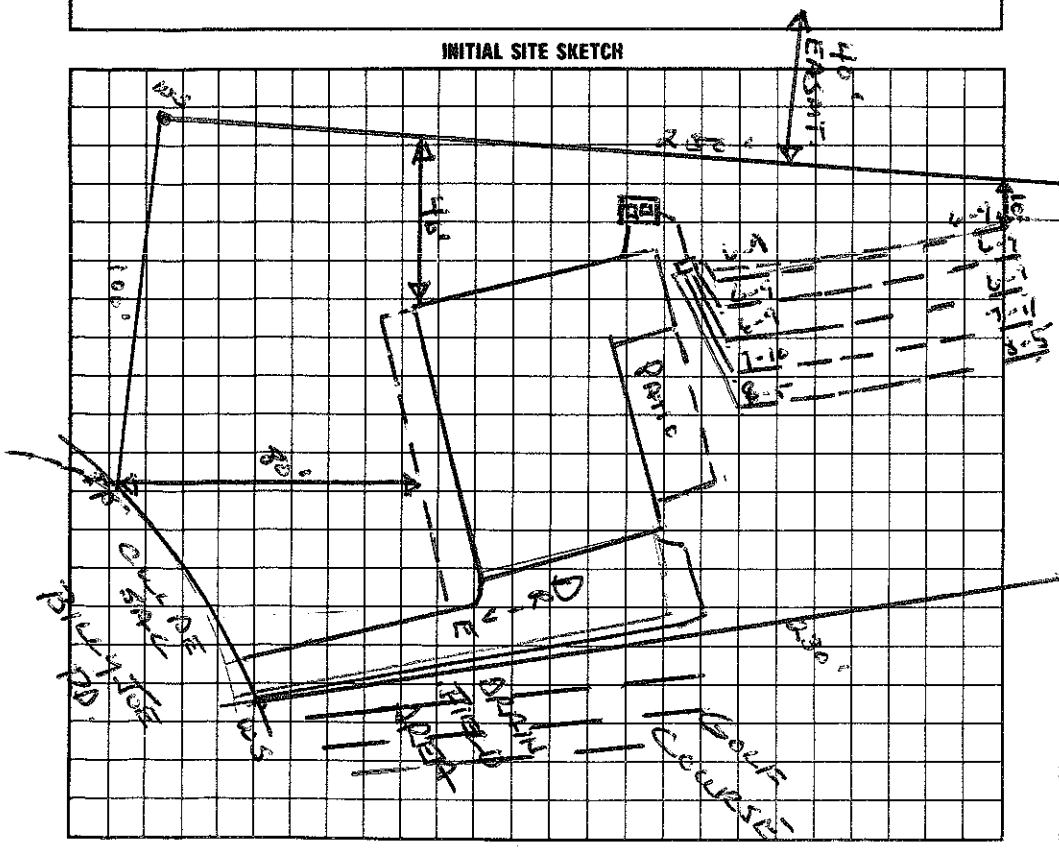

AS BUILT SKETCH

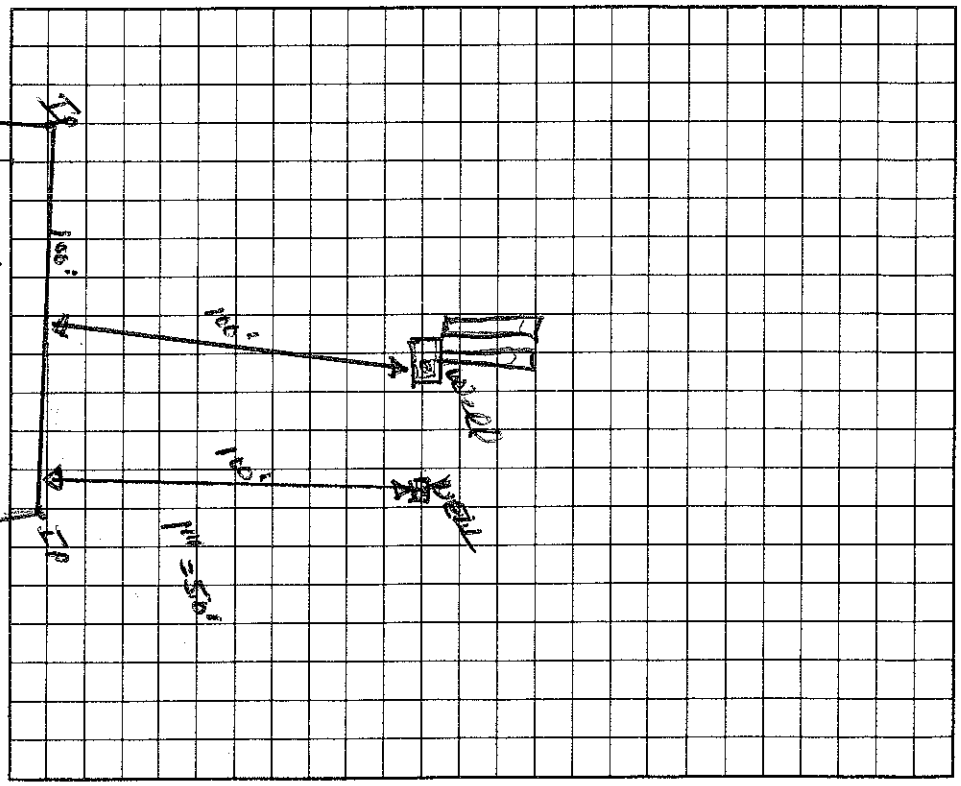

I understand that this permit can be suspended or revoked if any false information is supplied toward securing the permit/any unauthorized changes are made to the site/any unauthorized changes are made in the installation of the system.

Signed: ~~X~~ Emily Bumgenener

Improvement Permit by: Wesley Sparks R.S. date 7/18/96

Existing System Inspection by: Wesley Sparks R.S. date 7/18/96

Installed by: Richard Abernathy

Certificate of Completion by: Wesley Sparks R.S. date 2/25/97

Operation Permit by: Wesley Sparks R.S. date 2/25/97

HEALTH DEPT. COPY: WHITE INSPECTION COPY (FINAL): GREEN OWNER COPY (FINAL): YELLOW INSPECTION COPY (INITIAL): PINK OWNER COPY (INITIAL): GOLD