IREDELL COUNTY HEALTH DEPARTMENT

AUTHORIZATION TO CONSTRUCT

4.00

STATESVILLE 704-878-5305 MOORESVILLE 704-664-5281

IMPROVEMENT PERMIT / CERTIFICATE OF COMPLETION / OPERATION PERMIT / EXISTING SYSTEM INSPECTION

PROPERTY DESCRIPTION NO. 25698 DATE 1/27/97 TAX MAP NO. 24-7-A-64 4636 85 4856 Watershed: ☑ Yes ☑ No

OWNER OR CONTRACTOR KEN KOONTZ PHONE: Business 662-6556 Home

ADDRESS 191 KEATS RD. MOORESVILLE NC 28115

LOCATION BRAWLEY SCHOOL RD - CANVASBACK - TR OLD SQUAW - TL BILLY JOE - ON RT LT

SUBDIVISION MALLARD HEAD BLOCK / SECTION LOT 64 LOT AREA - SITE CLASS. PS DESIGN FLOW 360 GPD L.T.A.R. .3 GPD/FT²

Septic Tank: 1000 Gallons; STB 825 Date 9/20/97

Pump Tank: 1000 Gallons; PT 1007 Date 9/11/97

Pump Make: Zoeller Model W.E.3116 Serial No. 973562

Nitrification Field: No Fields 1 Square Feet 900 Linear Feet 300

No Lines ~~6 @ 50'~~ Trench Width 36" Max Trench Bottom Depth 24" Gravel Depth N/A

☑ New System ☐ Repair System Type: I, II, III, IV, V, VI

System Description: PUMP CHAMBERED OR SIMILAR LPP

Repair System Description:

Maintenance Agreement Required: ☐ Yes ☑ No

☑ House/Mod. Home No. Bedrooms 3

☐ Mobile Home No. Bathrooms 2.5

☐ Business No. Employees

☐ Other


☐ Slab ☑ Crawl Space ☐ Basement w/plumbing ☐ Basement wo/plumbing

Water Supply: ☐ Individual ☑ Community ☐ Public

Comments: 3@100 @3'

Comments:

INITIAL SITE SKETCH

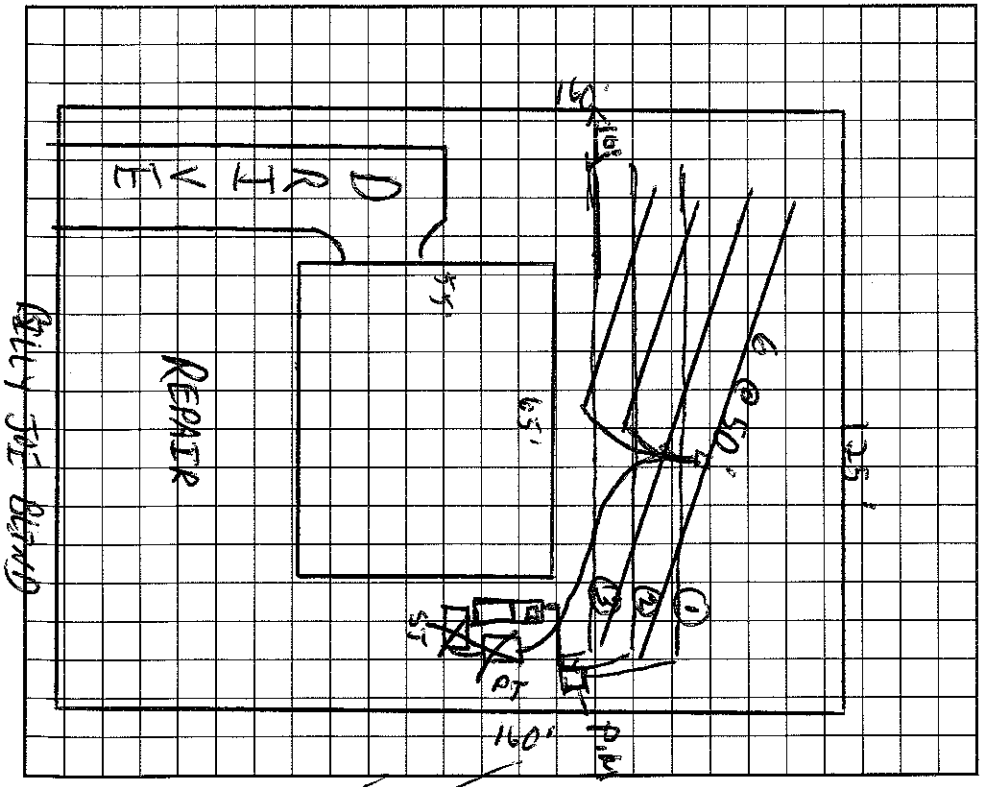

AS BUILT SKETCH

I understand that this permit can be suspended or revoked if any false information is supplied toward securing the permit/any unauthorized changes are made to the site/any unauthorized changes are made in the installation of the system. Improvement Permit is valid for 60 months from date of issuance.

Signed:

Installed by: Barry Thompson / FJ Erwin

Improvement Permit by: [signature] EHS date 1/27/97

Certificate of Completion by: Wesley Sparks R.S. date 2/26/98

AUTHORIZATION TO CONSTRUCT

~~Existing System Inspection by:~~ [signature] EHS date 1/27/97

Operation Permit by: Wesley Sparks R.S. date 2/26/98

HEALTH DEPT. COPY: WHITE INSPECTION COPY (FINAL): GREEN OWNER COPY (FINAL): YELLOW INSPECTION COPY (INITIAL): PINK OWNER COPY (INITIAL): GOLD