IREDELL COUNTY HEALTH DEPARTMENT

STATESVILLE 704-878-5305 MOORESVILLE 704-664-5281

IMPROVEMENT PERMIT / AUTHORIZATION TO CONSTRUCT / OPERATION PERMIT / EXISTING SYSTEM INSPECTION

PERMIT# 07841B PIN# ~~4636855525~~ 4636-85-7525 DATE Jan. 9, '99

OWNER OR CONTRACTOR Genesis Homes (Dave) PHONE: Business _____ Home _____

ADDRESS PO Box 6219 Mooresville

LOCATION 304 Canvasback Rd. Brawley Sch Rd TL Canvasback on Right across from Broadbill (Woodland Hills)

SUBDIVISION Mallard Head BLOCK / SECTION _____ LOT 89 LOT AREA .48ac SITE CLASS. 95 DESIGN FLOW 360gpd L.T.A.R. .3

Septic Tank: 1000 Gallons; STB 794 Date 2/1/99
Pump Tank: _____ Gallons; PT _____ Date _____
Pump Make: _____ Model _____ Serial No. _____
Nitrification Field: No Fields 1 Square Feet 1200 Linear Feet 400
No Lines 4@100' Trench Width 36" Max Trench Bottom Depth 36"

☑ New System ☐ Repair System Type: I, II, III, IV, V, VI
System Description: Gravity Conventional
Repair System Description: pump & pm - 25% red / Innovative
Maintenance Agreement Required: ☐ Yes ☑ No

Gravel Depth 12"

☑ House/Mod. Home No. Bedrooms 3
☐ Mobile Home No. Bathrooms 2½
☐ Business No. Employees _____
☐ Other _____

☐ Slab ☑ Crawl Space ☐ Basement w/plumbing ☐ Basement wo/plumbing


Water Supply: ☐ Individual ☑ Public ☑ Community

Comments:/Conditions: Effluent filter required on septic tank.

Comments:/Conditions:

INITIAL SITE SKETCH

1"=50'

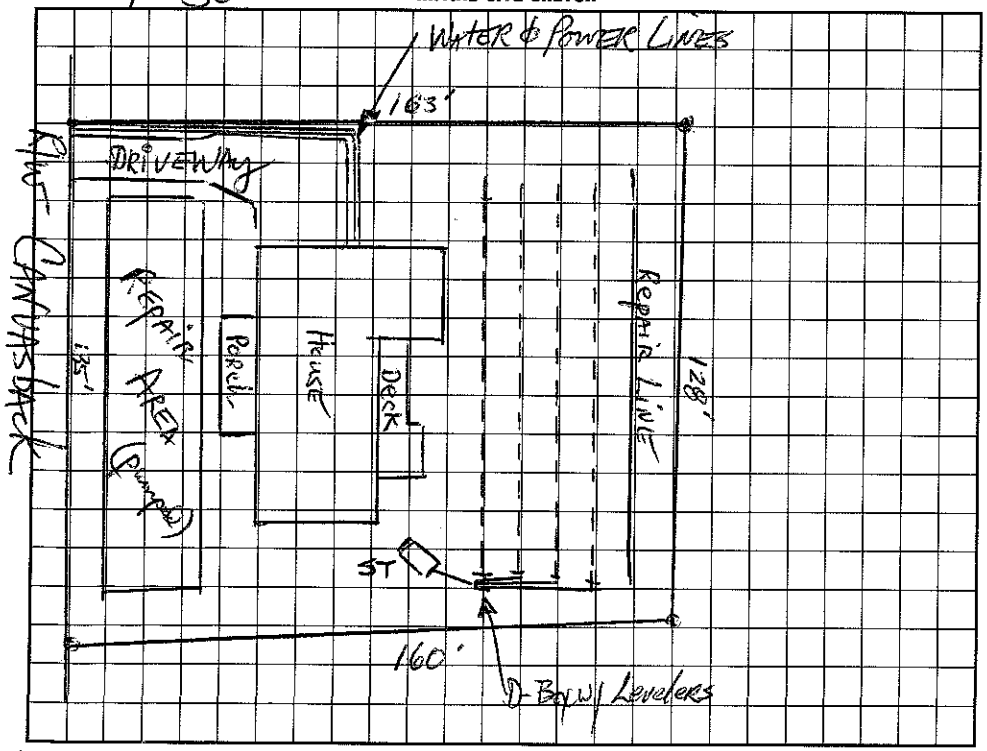

AS BUILT SKETCH

I understand that this permit can be suspended or revoked if any false information is supplied toward securing the permit/any unauthorized changes are made to the site/any unauthorized changes are made in the installation of the system. Improvement Permit with plat valid without expiration. Improvement Permit with site plan valid for sixty months. Authorization to Construct is valid for a period equal to that of Improvement Permit – not to exceed sixty months.

Signed: Genesis Homes / Robert Jordy date 1-11-99

Improvement Permit by: David R. Hinson, RS date 1-9-99

Authorization to Construct by: David R. Hinson, RS date 1-9-99

Installed by: Curt Dunning

Operation Permit by: Wesley Sparks RS date 6/30/99

Existing System Inspection by: _____ date _____

HEALTH DEPT. COPY: WHITE INSPECTION COPY (FINAL): GREEN OWNER COPY (FINAL): YELLOW INSPECTION COPY (INITIAL): PINK OWNER COPY (INITIAL): GOLD