IREDELL COUNTY HEALTH DEPARTMENT

STATESVILLE 704-878-5305 MOORESVILLE 704-664-5281

(3;00) 528-1028

IMPROVEMENT PERMIT / AUTHORIZATION TO CONSTRUCT / OPERATION PERMIT / EXISTING SYSTEM INSPECTION

PERMIT# 078083 PIN# 4636 85 7658 DATE 12/11/98

OWNER OR CONTRACTOR Paula Tew PHONE: Business 662-6808 Home

ADDRESS 480 Lakeview Shores Loop. Mooresville, NC. 28117

LOCATION Conners back rd, Brandy St to Conners back .9 mile (R) across from Woodlake Loop.

SUBDIVISION MALLARD HEAD BLOCK / SECTION LOT 88 LOT AREA .45 SITE CLASS. PS DESIGN FLOW 360 L.T.A.R. .3

Septic Tank: 1000 Gallons; STB 160 Date 4/19/99
Pump Tank: Gallons; PT Date
Pump Make: Model Serial No.
Nitrification Field: No Fields 1 Square Feet 900* Linear Feet 300*
No Lines 3@4 Trench Width 36" Max Trench Bottom Depth 36" Gravel Depth SAND

[X] New System [ ] Repair System Type: I, II, (III), IV, V, VI
System Description: GRAVITY -CH. PLASTIC
Repair System Description: Prefab. Panel Block 16"
Maintenance Agreement Required: [ ] Yes [ ] No


[X] House/Mod. Home No. Bedrooms 3
[ ] Mobile Home No. Bathrooms 3
[ ] Business No. Employees
[ ] Other
[ ] Slab [ ] Crawl Space [ ] Basement w/plumbing [ ] Basement wo/plumbing

Water Supply: [ ] Individual [ ] Public [X] Community CORRIHER

Comments:/Conditions: * 25% Reduction given - Install where shown here.

Comments:/Conditions: PUT IN AS DRAWN - BUT DEEP ON UPPER LS.VR.

INITIAL SITE SKETCH

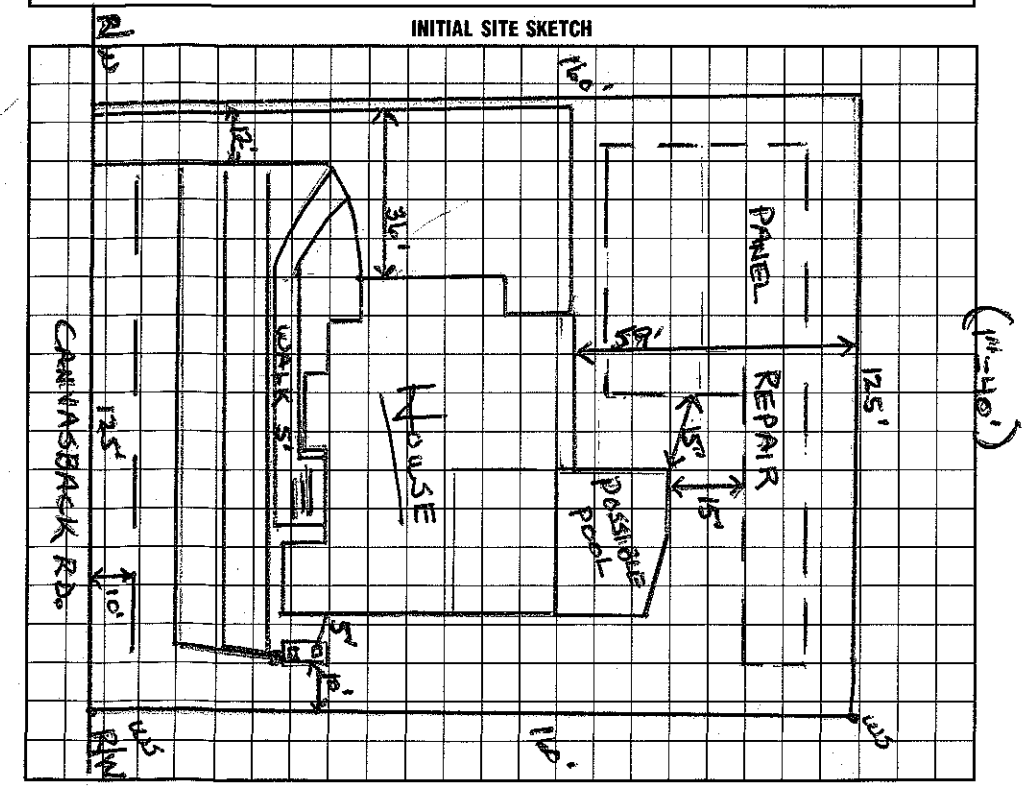

AS BUILT SKETCH

I understand that this permit can be suspended or revoked if any false information is supplied toward securing the permit/any unauthorized changes are made to the site/any unauthorized changes are made in the installation of the system. Improvement Permit with plat valid without expiration. Improvement Permit with site plan valid for sixty months. Authorization to Construct is valid for a period equal to that of Improvement Permit – not to exceed sixty months.

Signed: * Paula S. Tew date 12/15/98

Improvement Permit by: date

Authorization to Construct by: Wesley Sparks R.S. date 12/11/98

Installed by: BARRY SEGMON

Operation Permit by: KS date 5/20/99

Existing System Inspection by: date

HEALTH DEPT. COPY: WHITE INSPECTION COPY (FINAL): GREEN OWNER COPY (FINAL): YELLOW INSPECTION COPY (INITIAL): PINK OWNER COPY (INITIAL): GOLD