IREDELL COUNTY HEALTH DEPARTMENT

Authorization to Construct (2:30)

STATESVILLE 704-878-5305 MOORESVILLE 704-664-5281

IMPROVEMENT PERMIT / ~~CERTIFICATE OF COMPLETION~~ / OPERATION PERMIT / EXISTING SYSTEM INSPECTION

PROPERTY DESCRIPTION NO. 070388 DATE 12/5/97 TAX MAP NO. 4636857882 Watershed: [X] Yes [ ] No

OWNER OR CONTRACTOR John F. West PHONE: Business _____ Home _____

ADDRESS 10406 Summit Square Leesburg, Fl. 34788O

LOCATION Canvasback on (R) Before Broadbill Loop

SUBDIVISION MALLARD HEAD BLOCK / SECTION _____ LOT 87 LOT AREA .45 AC SITE CLASS. PS DESIGN FLOW 360 L.T.A.R. .3

Septic Tank: 1000 Gallons; STB 825 Date 3/1/98
Pump Tank: _____ Gallons; PT _____ Date _____
Pump Make: _____ Model _____ Serial No. _____
Nitrification Field: No Fields 1 Square Feet 1200 Linear Feet 400
No Lines 4 Trench Width 36" Max Trench Bottom Depth 36" Gravel Depth 12"

[X] New System [ ] Repair System Type: I, (II) III, IV, V, VI
System Description: GRAVITY - CONVENTIONAL
Repair System Description: GRAVITY 16" PIPES
Maintenance Agreement Required: [ ] Yes [X] No


[X] House/Mod. Home No. Bedrooms 3
[ ] Mobile Home No. Bathrooms 2.5
[ ] Business No. Employees _____
[ ] Other _____
[ ] Slab [X] Crawl Space [ ] Basement w/plumbing [ ] Basement wo/plumbing

Water Supply:
[ ] Individual
[X] Community
[ ] Public

Comments:

Comments:
> UPPER LINES CHECKED

INITIAL SITE SKETCH

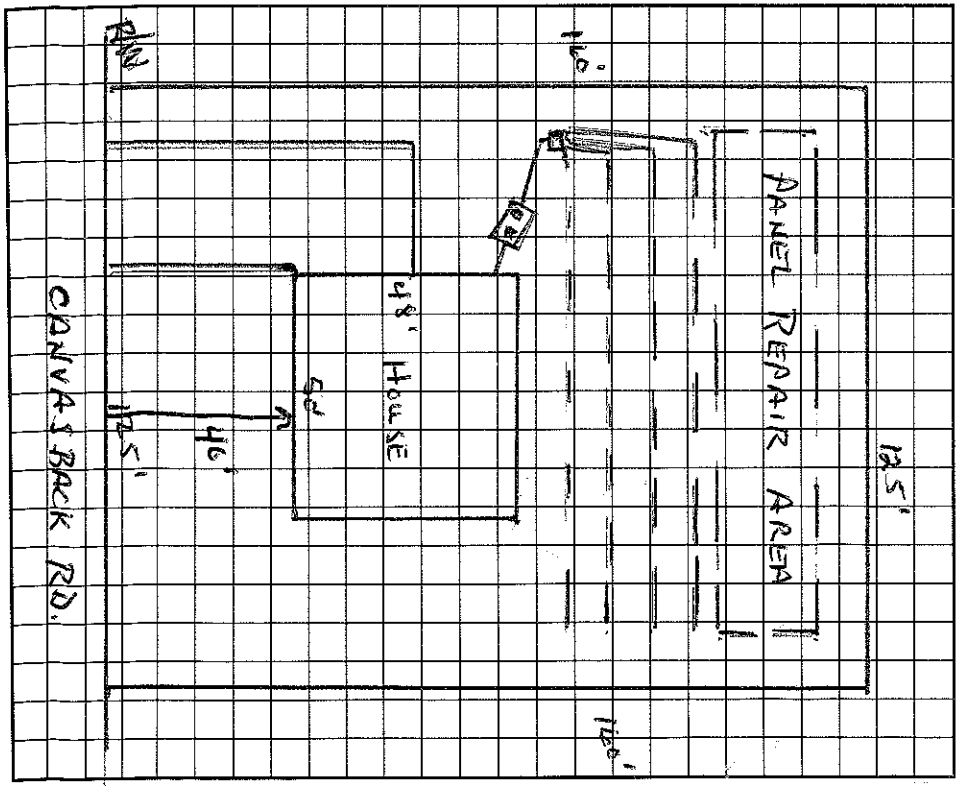

AS BUILT SKETCH

FAXED
704-799-1952
2-24-11

I understand that this permit can be suspended or revoked if any false information is supplied toward securing the permit/any unauthorized changes are made to the site/any unauthorized changes are made in the installation of the system. Improvement Permit is valid for 60 months from date of issuance.

Signed: Don Jackson

Improvement Permit by: Wesley Sparks RS. date 12/5/97

Existing System Inspection by: Wesley Sparks RS. date 12/5/97

Installed by: WAYNE CONTZ

Certificate of Completion by: _____ date _____

Operation Permit by: C. [signature] date 5/26/98

HEALTH DEPT. COPY: WHITE INSPECTION COPY (FINAL): GREEN OWNER COPY (FINAL): YELLOW INSPECTION COPY (INITIAL): PINK OWNER COPY (INITIAL): GOLD