IREDELL COUNTY HEALTH DEPARTMENT

STATESVILLE 704-878-5305 MOORESVILLE 704-664-5281

IMPROVEMENT PERMIT / AUTHORIZATION TO CONSTRUCT / OPERATION PERMIT / EXISTING SYSTEM INSPECTION

PERMIT# 94866 PIN# 4636 85 8289

OWNER OR CONTRACTOR John Poore Builders PHONE: Business 704-361-1845 Home DATE 10/15/01

ADDRESS PO Box 1437 Matthews NC 28106

LOCATION Brawley Sch Rd TL Canvasback TL Broadbill on Corner

SUBDIVISION Wood Land Hills BLOCK / SECTION 8 LOT 112 LOT AREA 0.81 Ac SITE CLASS. PS DESIGN FLOW 360 L.T.A.R. 0.3

Septic Tank: 1000 Gallons: STB 794 Date 2/10/00

Pump Tank: Gallons: PT Date

Pump Make: Model Serial No.

Nitrification Field: No Fields 1 Square Feet 900 Linear Feet 300

No Lines 6 @ 50' Trench Width 36" Max Trench Bottom Depth 36" Gravel Depth —

☒ New System ☐ Repair System Type: I, II, III, IV, V, VI

System Description: Gravity 25% Reduct.

Repair System Description: Pump 25% Red.

Maintenance Agreement Required: ☐ Yes ☒ No

☒ House/Mod. Home ☐ Mobile Home ☐ Business ☐ Other


No. Bedrooms 3 No. Bathrooms 2 No. Employees

Water Supply: ☐ Individual ☐ Public ☒ Community

☐ Slab ☒ Crawl Space ☐ Basement w/plumbing ☐ Basement wo/plumbing

Comments:/Conditions:

INITIAL SITE SKETCH 1" = 50'

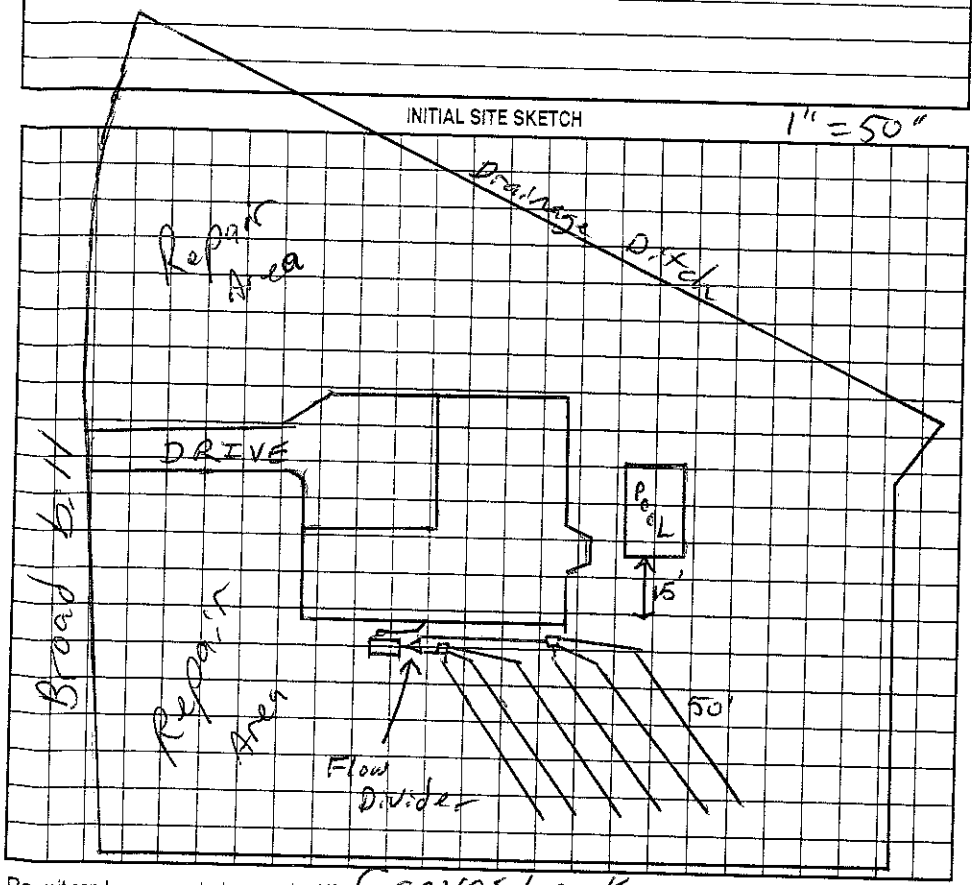

Comments:/Conditions:

AS BUILT SKETCH

Permit can be suspended or revoked if any false information is supplied toward securing the permit/any unauthorized changes are made to the site/any unauthorized changes are made in the installation of the system. Improvement Permit with plat valid without expiration. Improvement Permit with site plan valid for sixty months. Authorization to Construct is valid for a period equal to that of Improvement Permit – not to exceed sixty months.

Signed: date

Improvement Permit by: RSI date 10/15/01

Authorization to Construct by: RSI date 10/15/01

Installed by: Holman Const.

Operation Permit by: RSI date 10/17/01

Existing System Inspection by: date

HEALTH DEPT COPY WHITE