IREDELL COUNTY HEALTH DEPARTMENT

4636859523

STATESVILLE 704-878-5305 MOORESVILLE 704-664-5281

IMPROVEMENT PERMIT / CERTIFICATE OF COMPLETION / OPERATION PERMIT / EXISTING SYSTEM INSPECTION

PROPERTY DESCRIPTION NO. 19940 DATE 12/22/94 TAX MAP NO. 2G-19-A-42 Watershed: ☐ Yes ☒ No

OWNER OR CONTRACTOR Robert Delonis PHONE: Business _____ Home 664-2948

ADDRESS 105 Broadbill Dr. Mooresville NC 28115

LOCATION 1100 TL on Conover back TL Broadbill (Woodland Hills entrance) 1st house on R

SUBDIVISION Woodland Hills BLOCK / SECTION D LOT B 42 LOT AREA ~.7Ac SITE CLASS. P DESIGN FLOW _____ L.T.A.R. _____

Septic Tank: 1250 Gallons; STB _____ Date _____

Pump Tank: _____ Gallons; PT _____ Date _____

Pump Make: _____ Model _____ Serial No. _____

Nitrification Field: No Fields ____ Square Feet 900 Linear Feet 300

No Lines 2 Trench Width 36" Max Trench Bottom Depth _____ Gravel Depth _____

☐ New System ☐ Repair System Type: I, ☒ II, III, IV, V, VI

System Description: Existing System

Repair System Description: _____

Maintenance Agreement Required: ☐ Yes ☐ No

☒ House/Mod. Home No. Bedrooms 3

☐ Mobile Home No. Bathrooms 2.5

☐ Business No. Employees ____

☐ Other _____

☐ Slab ☒ Crawl Space ☐ Basement w/plumbing ☐ Basement wo/plumbing

Water Supply: ☐ Individual ☒ Community ☐ Public


Comments:

Comments:

Existing System - Not functioning & under measured pressure

INITIAL SITE SKETCH

AS BUILT SKETCH

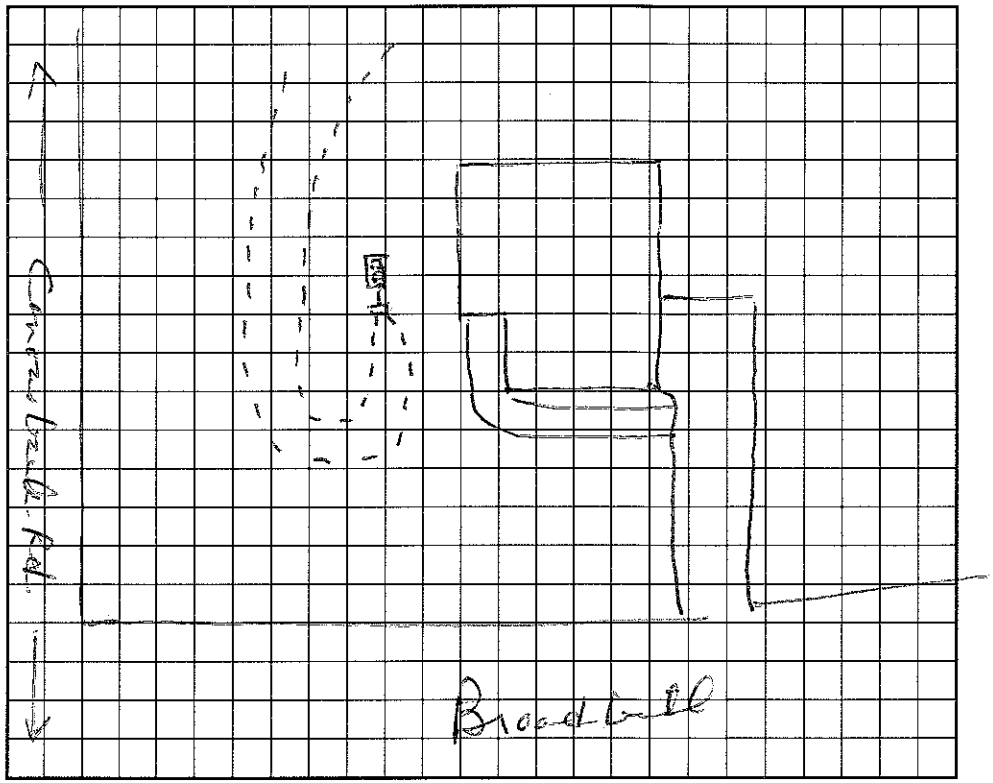

I understand that this permit can be suspended or revoked if any false information is supplied toward securing the permit/any unauthorized changes are made to the site/any unauthorized changes are made in the installation of the system. Improvement Permit is valid for 60 months from date of issuance.

Signed: _____ Installed by: _____

Improvement Permit by: _____ date _____ Certificate of Completion by: _____ date _____

Existing System Inspection by: Wesley Sparks R.S. date 12/22/94 Operation Permit by: _____ date _____

HEALTH DEPT. COPY: WHITE INSPECTION COPY (FINAL): GREEN OWNER COPY (FINAL): YELLOW INSPECTION COPY (INITIAL): PINK OWNER COPY (INITIAL): GOLD