IREDELL COUNTY HEALTH DEPARTMENT

STATESVILLE 704-878-5305 MOORESVILLE 704-664-5281

130.00 Paid 3:00

IMPROVEMENT PERMIT / AUTHORIZATION TO CONSTRUCT / OPERATION PERMIT / EXISTING SYSTEM INSPECTION

PERMIT# 112059 PIN# 4636-95-5388.7 4636859703

OWNER OR CONTRACTOR Tegland - Brown Const. DATE 5/19/05

ADDRESS 7502 Windriere Dr. Cornelius NC 28031 PHONE: Business 704-895-9652 Home

LOCATION Brawley Sch, TL Canvasback, TL Mardarin, 1st on Rt

SUBDIVISION Woodland Hills BLOCK / SECTION 10 LOT 1 LOT AREA 0.69AC SITE CLASS 95 DESIGN FLOW 480 L.T.A.R. 0.3

Septic Tank: 1000 Gallons; STB 312 Date 7-21-02

Pump Tank: Gallons; PT Date

Pump Make: Model Serial No.

Nitrification Field: No Fields 1 Square Feet 1200 Linear Feet 400

No Lines 4 @ 100' Trench Width 36" Max Trench Bottom Depth 36" Gravel Depth +

☒ New System ☐ Repair System Type: I, II, (III), IV, V, VI

System Description: Gravity 25% Reduction

Repair System Description: Same Innovative

Maintenance Agreement Required: ☐ Yes ☒ No

☒ House/Mod. Home ☐ Mobile Home ☐ Business ☐ Other

No. Bedrooms 4 No. Bathrooms 3 No. Employees


Water Supply: ☐ Individual ☐ Public ☒ Community

☐ Slab ☒ Crawl Space ☐ Basement w/plumbing ☐ Basement wo/plumbing

Comments:/Conditions:

Comments:/Conditions:

INITIAL SITE SKETCH 1" = 50'

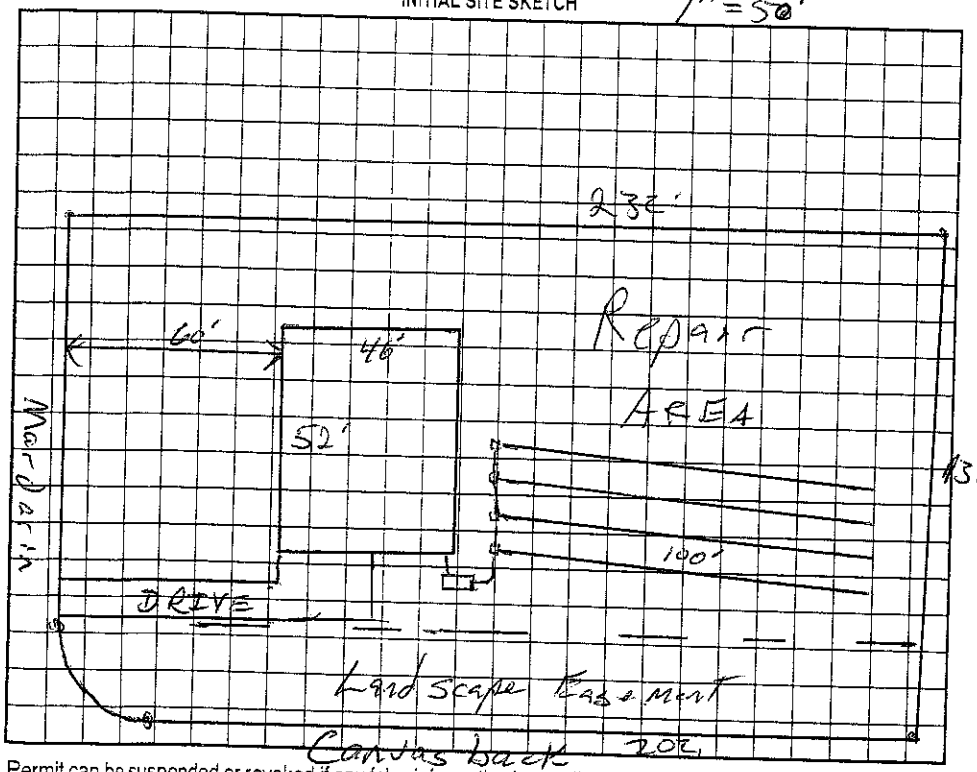

AS BUILT SKETCH

Installed 5-80' Plastic Chamber Drainlines

Permit can be suspended or revoked if any false information is supplied toward securing the permit/any unauthorized changes are made to the site/any unauthorized changes are made in the installation of the system. Improvement Permit with plat valid without expiration. Improvement Permit with site plan valid for sixty months. Authorization to Construct is valid for a period equal to that of Improvement Permit – not to exceed sixty months.

Signed: W R Brown date 5/20/03

Improvement Permit by: RS date 5/19/05

Authorization to Construct by: date 5/19/03

Installed by: Richard Abernathy

Operation Permit by: Maria H Dolan RS date 11/21/03

Existing System Inspection by: date

HEALTH DEPT. COPY: WHITE OWNER COPY (FINAL): YELLOW OWNER COPY (INITIAL): PINK