IREDELL COUNTY HEALTH DEPARTMENT

STATESVILLE 704-878-5305 MOORESVILLE 704-664-5281

IMPROVEMENT PERMIT / AUTHORIZATION TO CONSTRUCT / OPERATION PERMIT / EXISTING SYSTEM

INSPECTION

PERMIT# 072470 PIN# 4636 86 1579 DATE 7/2/98

OWNER OR CONTRACTOR Genesis Homes / Eddie Jacks PHONE: Business 664-9309 Home

ADDRESS PO Box 6219 Mooresville, NC 28115

LOCATION Canvasback TR Old Squaw TL Billy Joe on (R) corner at Pintail Run

SUBDIVISION Mallard Head BLOCK / SECTION LOT 55 LOT AREA .51 Ac SITE CLASS PS DESIGN FLOW 360 L.T.A.R. .3

Septic Tank: 1000 Gallons; STB 794 Date 5-3-98
Pump Tank: Gallons; PT Date
Pump Make: Model Serial No.
Nitrification Field: No Fields 1 Square Feet 900 Linear Feet * 300
No Lines 3 Trench Width 36" Max Trench Bottom Depth 32" Gravel Depth 3 AND.

☒ New System ☐ Repair System Type: I, II, (III) IV, V, VI
System Description: Gravity - Type III
Repair System Description: Same
Maintenance Agreement Required: ☐ Yes ☐ No


☒ House/Mod. Home No. Bedrooms 3
☐ Mobile Home No. Bathrooms 2
☐ Business No. Employees
☐ Other
☐ Slab ☒ Crawl Space ☐ Basement w/plumbing ☐ Basement wo/plumbing

Water Supply: ☐ Individual ☐ Public ☒ Community

Comments:/Conditions: * 25% reduction for Type III
Drainfield

Comments:/Conditions:

INITIAL SITE SKETCH 150'

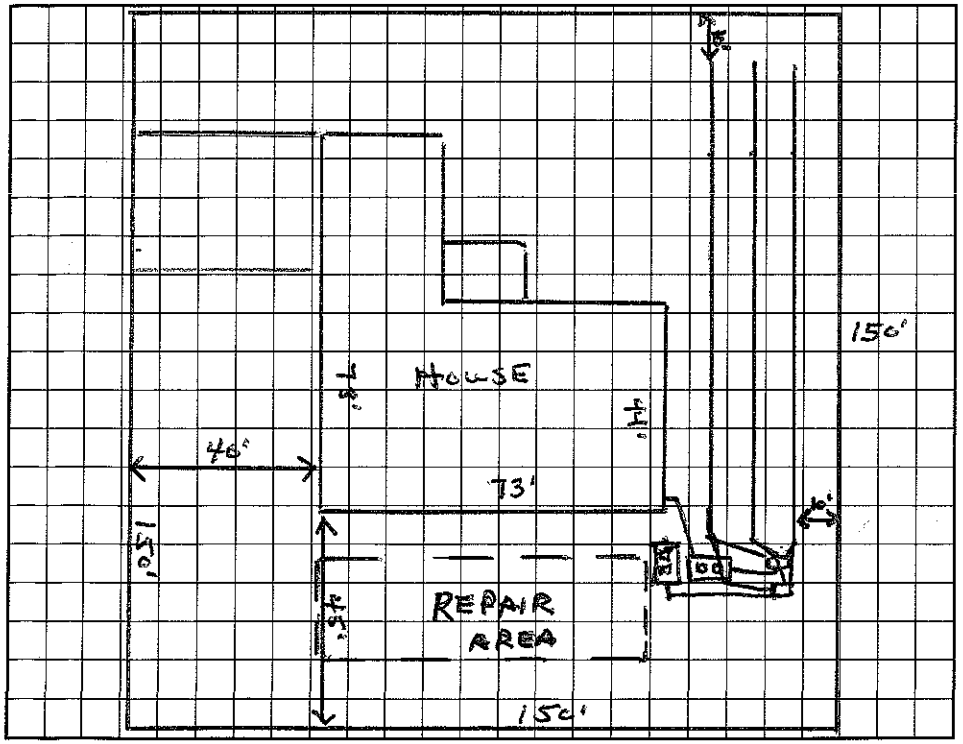

AS BUILT SKETCH

I understand that this permit can be suspended or revoked if any false information is supplied toward securing the permit/any unauthorized changes are made to the site/any unauthorized changes are made in the installation of the system. Improvement Permit with plat valid without expiration. Improvement Permit with site plan valid for sixty months. Authorization to Construct is valid for a period equal to that of Improvement Permit – not to exceed sixty months.

Signed: * E. Jacks date 8/26/98
Improvement Permit by: Wesley Sparks RS. date 7/2/98
Authorization to Construct by: Wesley Sparks RS date 7/2/98

Installed by: Curt Denning
Operation Permit by: Wesley Sparks RS. date
Existing System Inspection by: date

HEALTH DEPT. COPY: WHITE INSPECTION COPY (FINAL): GREEN OWNER COPY (FINAL): YELLOW INSPECTION COPY (INITIAL): PINK OWNER COPY (INITIAL): GOLD