IREDELL COUNTY HEATLH DEPARTMENT
ENVIRONMENTAL HEALTH DIVISION
PAGE 2: *SITE PLAN WORKSHEET*

SEE THE "SAMPLE SITE PLAN" BELOW. *INCOMPLETE SITE PLANS WILL BE RETURNED TO YOU FOR COMPLETION AND MAY RESULT IN A DELAY IN THE ISSUANCE OF YOUR SEPTIC SYSTEM PERMIT!!!*

Place an (X) beside each item as you complete the site plan:

- ✓ **Property Line measurements are clearly identified…**
- ✓ **All proposed structures are indicated…**
  SHOW: proposed house or business footprint, wells, water lines, patios, pools and decks, and any other item that will occupy space on the site
- ✓ **Front and side setbacks from property line…**
- ✓ **Preferred driveway location and configuration, preferred well location…**
- ✓ **Area you prefer your septic system to be placed…**
- ✓ **North arrow, or other sufficient indicator of direction…**

Circle N/A on the following if appropriate:

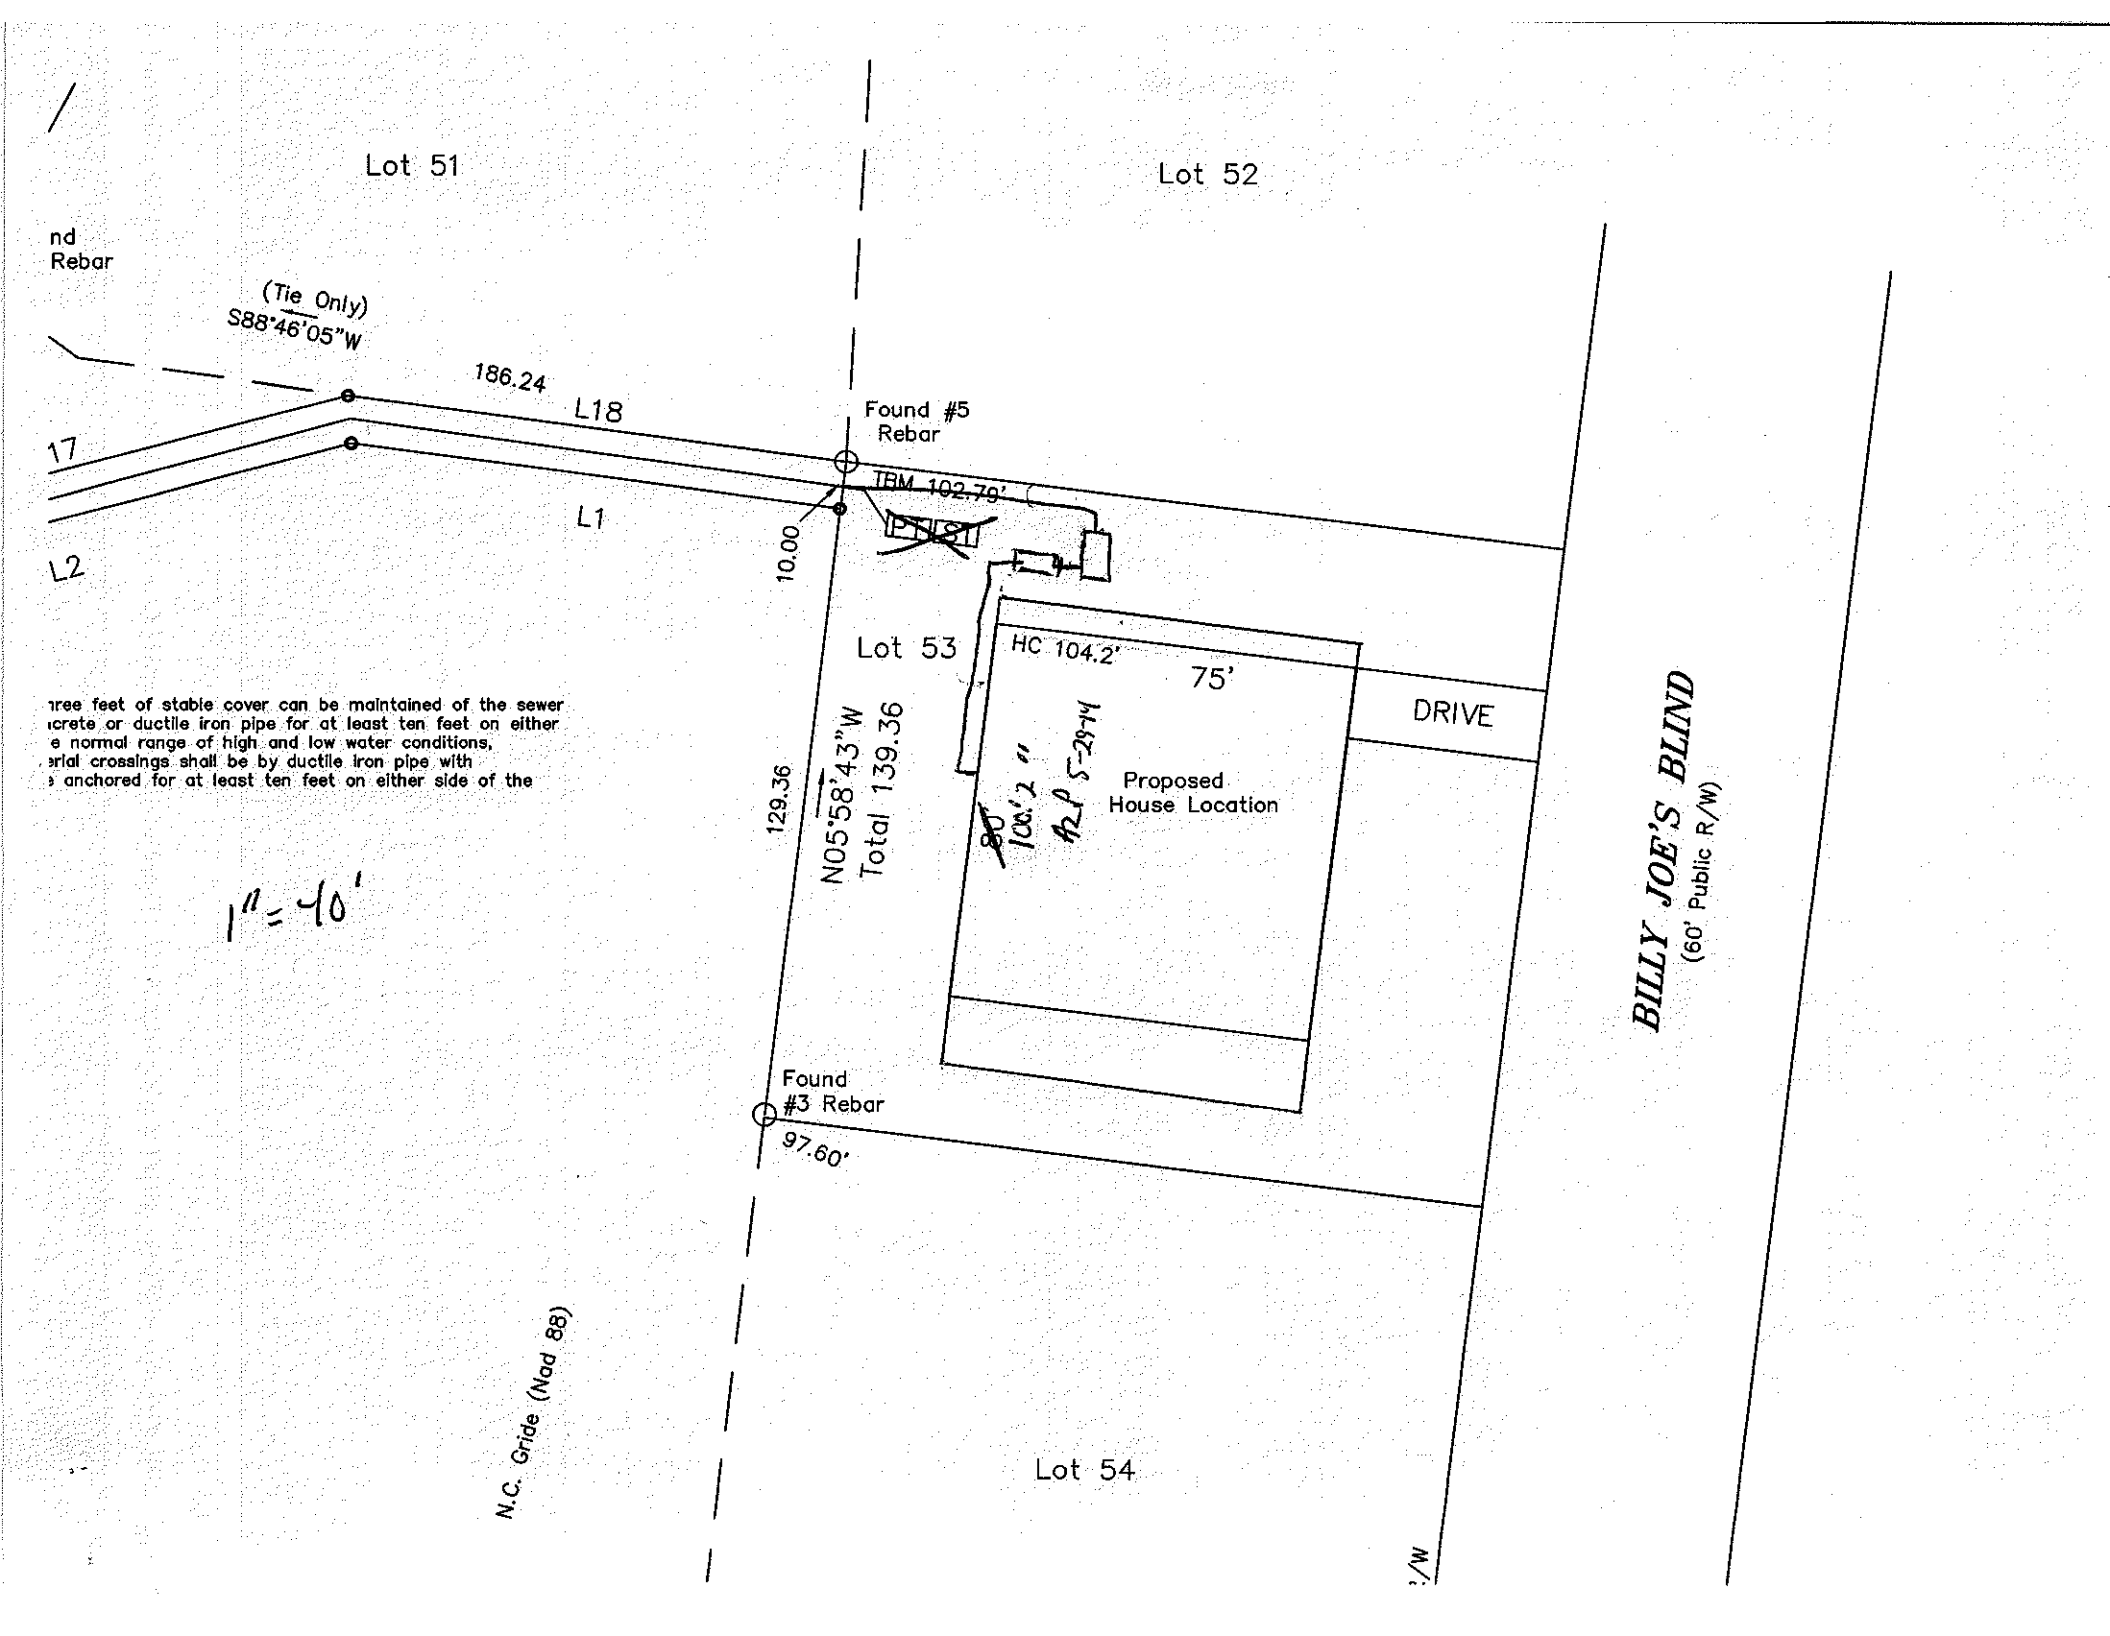
- ____ **Location of septic systems and wells within 100' of your property…** ~~N/A~~
- ____ **Location of easements and rights of ways on your property…** ~~N/A~~
- ____ **Location of any designated wetlands on the property…** ~~N/A~~

Signature: Alvin L. Pruett — 8-28-13

REQUIRED **property owner or owner's legal representative signature.** — **DATE**

USE THIS SPACE TO DRAW YOUR SITE PLAN

See Attached Site Plan.


Lot 51
Lot 52
nd
Rebar
(Tie Only)
S88°46'05"W
186.24
L18
17
L1
L2
Found #5
Rebar
TBM 102.79'
10.00
Lot 53
HC 104.2'
75'
DRIVE
129.36
N05°58'43"W
Total 139.36
Proposed
House Location
Found
#3 Rebar
97.60'
Lot 54
N.C. Gride (Nad 88)
BILLY JOE'S BLIND
(60' Public R/W)
ree feet of stable cover can be maintained of the sewer
crete or ductile iron pipe for at least ten feet on either
e normal range of high and low water conditions,
erial crossings shall be by ductile iron pipe with
anchored for at least ten feet on either side of the
1" = 40'