(1.00)

IREDELL COUNTY HEALTH DEPARTMENT

STATESVILLE 704-878-5305 MOORESVILLE 704-664-5281

IMPROVEMENT PERMIT / AUTHORIZATION TO CONSTRUCT / OPERATION PERMIT / EXISTING SYSTEM INSPECT

PERMIT# 073028 PIN# 4636862209 DATE 6/12/98

OWNER OR CONTRACTOR HAROLD FITZWATER PHONE: Business Home 352-343-7335

ADDRESS 33651 DOLORES CT LEESBURG FL 34788

LOCATION BRAWLEY SCHOOL - TL CANVASBACK - TR OLD SQUAW - TL BILLY JOE - CORNER

SUBDIVISION MALLARD HEAD BLOCK / SECTION LOT 56 ~~36~~ LOT AREA .50 ac SITE CLASS. 5 DESIGN FLOW 450 L.T.A.R. .3

Septic Tank: 1000 Gallons; STB 794 Date 9-6-98

Pump Tank: 1000 Gallons; PT 27 Date 8-3-98

Pump Make: H4O ROMATIC Model SK 100A1 Serial No.

Nitrification Field: No Fields 1 Square Feet 533 Linear Feet 270

No Lines 4 Trench Width 24" Max Trench Bottom Depth 36" Gravel Depth N/A

☑ New System ☐ Repair System Type: I, II, III, (IV) V, VI

System Description: PUMP PANEL OFFSITE

Repair System Description: SAME

Maintenance Agreement Required: ☑ Yes ☐ No

☑ House/Mod. Home No. Bedrooms 4

☐ Mobile Home No. Bathrooms 2

☐ Business No. Employees

☐ Other

☐ Slab ☑ Crawl Space ☐ Basement w/plumbing ☐ Basement wo/plumbing

Water Supply: ☑ Individual ☐ Public ☑ Community


Comments:/Conditions:

Comments:/Conditions:


150 GI DOSE = 7.0

30 @ 90 Cedar

INITIAL SITE SKETCH

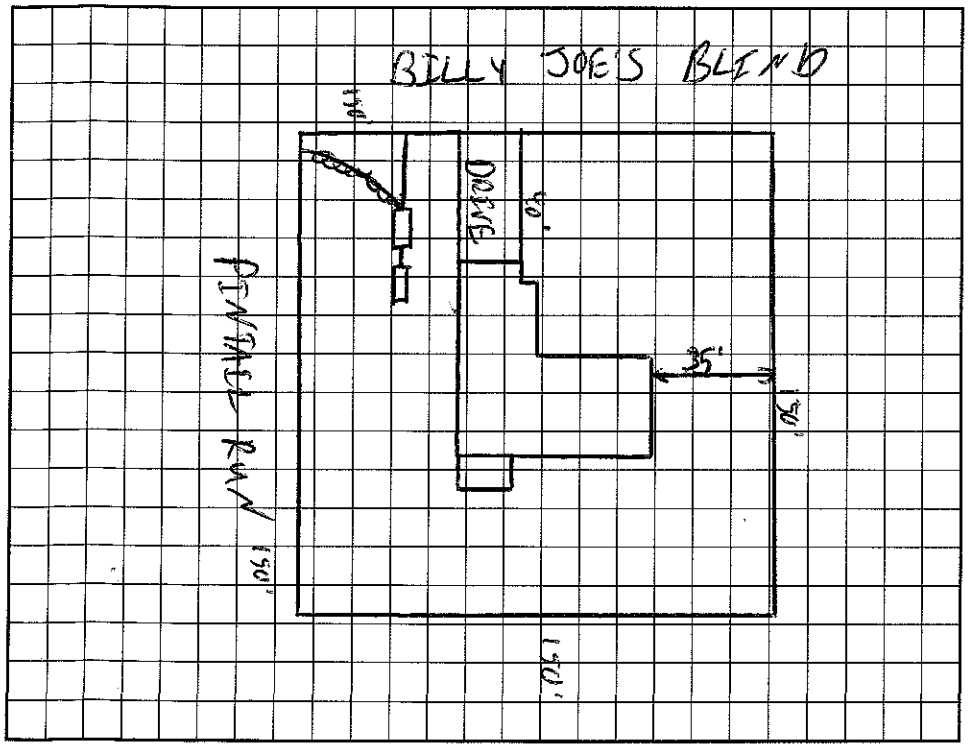

AS BUILT SKETCH

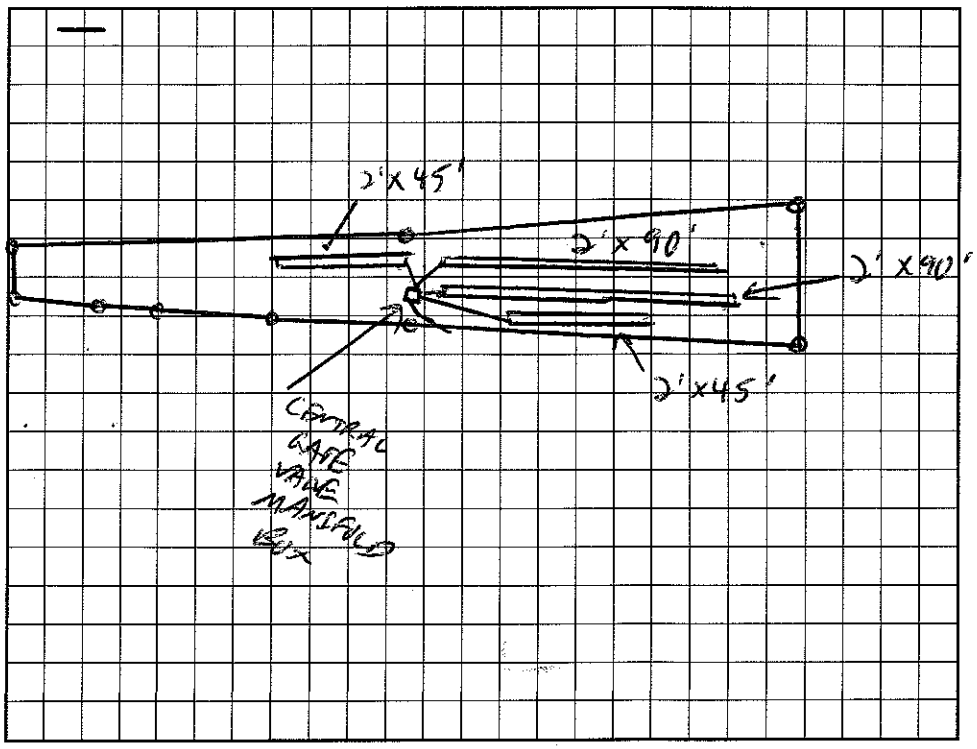

I understand that this permit can be suspended or revoked if any false information is supplied toward securing the permit/any unauthorized changes are made to the site/any unauthorized changes are made in the installation of the system. Improvement Permit with plat valid without expiration. Improvement Permit with site plan valid for sixty months. Authorization to Construct is valid for a period equal to that of Improvement Permit – not to exceed sixty months.

Signed John F. Hall date 6/12-98 Installed by: Curt Dunning

Improvement Permit by: C. Lyttle RS date 6/12/98 Operation Permit by: Marvin H. Watson RS date 12/2/98

Authorization to Construct by: C. Lyttle RS date 6/12/98 Existing System Inspection by: date

HEALTH DEPT. COPY: WHITE INSPECTION COPY (FINAL): GREEN OWNER COPY (FINAL): YELLOW INSPECTION COPY (INITIAL): PINK OWNER COPY (INITIAL): GOLD