IREDELL COUNTY HEALTH DEPARTMENT

STATESVILLE 704-878-5305 | MOORESVILLE 704-664-5281

IMPROVEMENT PERMIT / AUTHORIZATION TO CONSTRUCT / OPERATION PERMIT / EXISTING SYSTEM INSPECTION

175.00 Paid 3/30

PERMIT# 95554 PIN# 4636 86 3962 DATE 5/10/01

OWNER OR CONTRACTOR Select Properties PHONE: Business 704-947-8927 Home

ADDRESS 13318 Toka Ct Huntersville NC 28078

LOCATION Brawley Sch L Connsback, R Old Squaw, L Billy Joe 2nd on Lt. 111 Billy Joe Rd

SUBDIVISION Mallard Head BLOCK / SECTION LOT 72 LOT AREA 0.48 AC SITE CLASS. PS DESIGN FLOW 450 L.T.A.R. 0.3

Septic Tank: 1000 Gallons; STB 3/2 Date 3/3/02

Pump Tank: 1000 Gallons; PT 283 Date 2/27/02

Pump Make: Goulds Model WE03111M Serial No. B0260845

Nitrification Field: No Fields 1 Square Feet 1200 Linear Feet 400

No Lines 4@100' Trench Width 36" Max Trench Bottom Depth 18" Gravel Depth —

☒ New System ☐ Repair System Type: I, II, (III) IV, V, VI

System Description: Press. Man. Shallow 25%Red

Repair System Description: Same

Maintenance Agreement Required: ☐ Yes ☒ No

☒ House/Mod. Home ☐ Mobile Home ☐ Business ☐ Other

No. Bedrooms 4 No. Bathrooms 3 No. Employees


☐ Slab ☒ Crawl Space ☐ Basement w/plumbing ☐ Basement wo/plumbing

Water Supply: ☐ Individual ☒ Public ☒ Community

Comments/Conditions: Install Lines on Contour

Comments/Conditions:

INITIAL SITE SKETCH

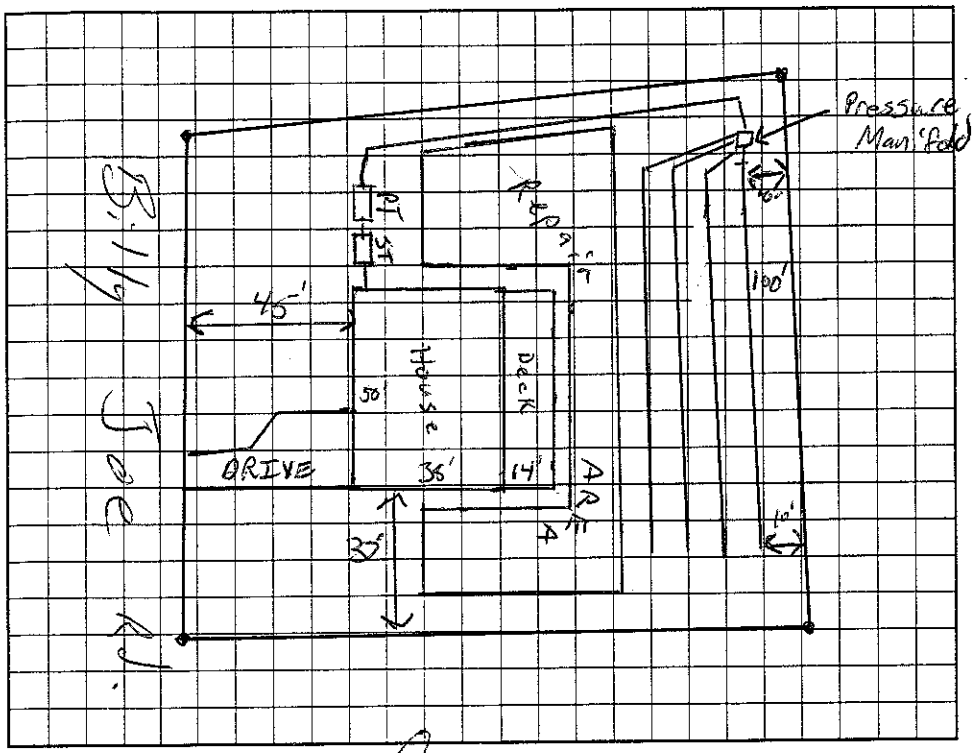

AS BUILT SKETCH

Installed As Drawn

E-2 Flow

Permit can be suspended or revoked if any false information is supplied toward securing the permit/any unauthorized changes are made to the site/any unauthorized changes are made in the installation of the system. Improvement Permit with plat valid without expiration. Improvement Permit with site plan valid for sixty months. Authorization to Construct is valid for a period equal to that of Improvement Permit – not to exceed sixty months.

Signed: Jack M. Gillie date

Improvement Permit by: RS date 5/10/01

Authorization to Construct by: RS date 5/10/01

Installed by: Holman Const.

Operation Permit by: RS date 4/12/02

Existing System Inspection by: date

HEALTH DEPT. COPY: WHITE OWNER COPY (FINAL): YELLOW OWNER COPY (INITIAL): PINK