IREDELL COUNTY HEALTH DEPARTMENT

AUTHORIZATION TO CONSTRUCT

STATESVILLE 704-878-5305 MOORESVILLE 704-664-5281

(1130) QL # 4636864040

IMPROVEMENT PERMIT / ~~CERTIFICATE OF COMPLETION~~ / OPERATION PERMIT / EXISTING SYSTEM INSPECTION

PROPERTY DESCRIPTION NO. 24564 DATE 9/4/96 TAX MAP NO. 2K-9-A-65 Watershed: ☑ Yes ☐ No

OWNER OR CONTRACTOR ERNEST A STAFFORD PHONE: Business _____ Home 549-8454

ADDRESS 8621-D DRYBROOK RD. CHARLOTTE NC

LOCATION BRAWLEY SCHOOL, TL CANVASBACK, TR OLD SHAW, TL BILLY JOE'S BLVD - JUST BEFORE CUL-DE-SAC.

SUBDIVISION MALLARD HEAD BLOCK / SECTION _____ LOT 65 LOT AREA .55 AC SITE CLASS. PS DESIGN FLOW 360GPD L.T.A.R. .36GPD/FT²

Septic Tank: 1000 Gallons; STB 794 Date 12/12/96

Pump Tank: _____ Gallons; PT 27 Date 2/25/97

Pump Make: GOULDS Model WE0511H Serial No. K96 45404

Nitrification Field: No Fields 1 Square Feet 600 Linear Feet 200

No Lines 2 Trench Width 24" Max Trench Bottom Depth 36" Gravel Depth 54MD

☑ New System ☐ Repair System Type: I, II, III, (IV) V, VI

System Description: PUMP PANEL

Repair System Description: PUMP PANEL

☑ Maintenance Agreement Required ☑ Yes ☐ No

☑ Slab ☐ Crawl Space ☐ Basement w/plumbing ☐ Basement wo/plumbing

☑ House/Mod. Home No. Bedrooms 3

☐ Mobile Home No. Bathrooms 2½

☐ Business No. Employees _____

☐ Other _____


Water Supply: ☐ Individual ☑ Community ☐ Public

Comments: COPY OF EASEMENT IS ATTACHED.


Comments: LINES, TANKS, PRESSURE CHECKED 4/16/97

EASEMENT TO BE MOVED OUT 3' - LINES BE 3' TO PROPERTY LINES.

INITIAL SITE SKETCH

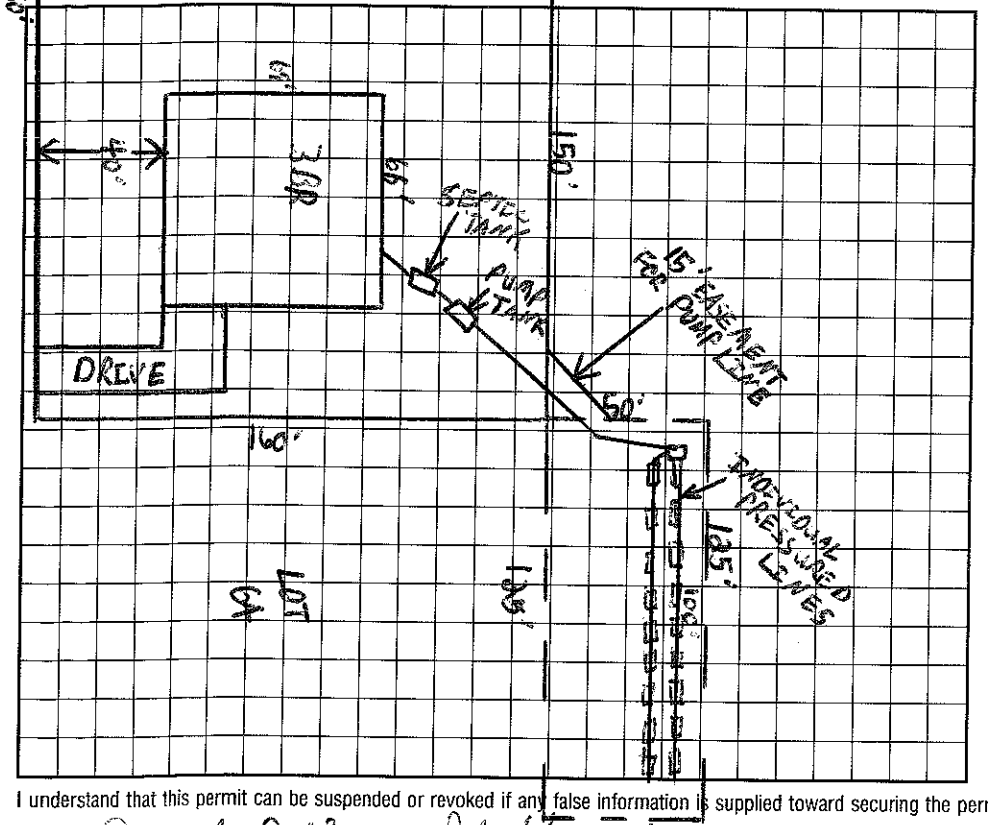

AS BUILT SKETCH

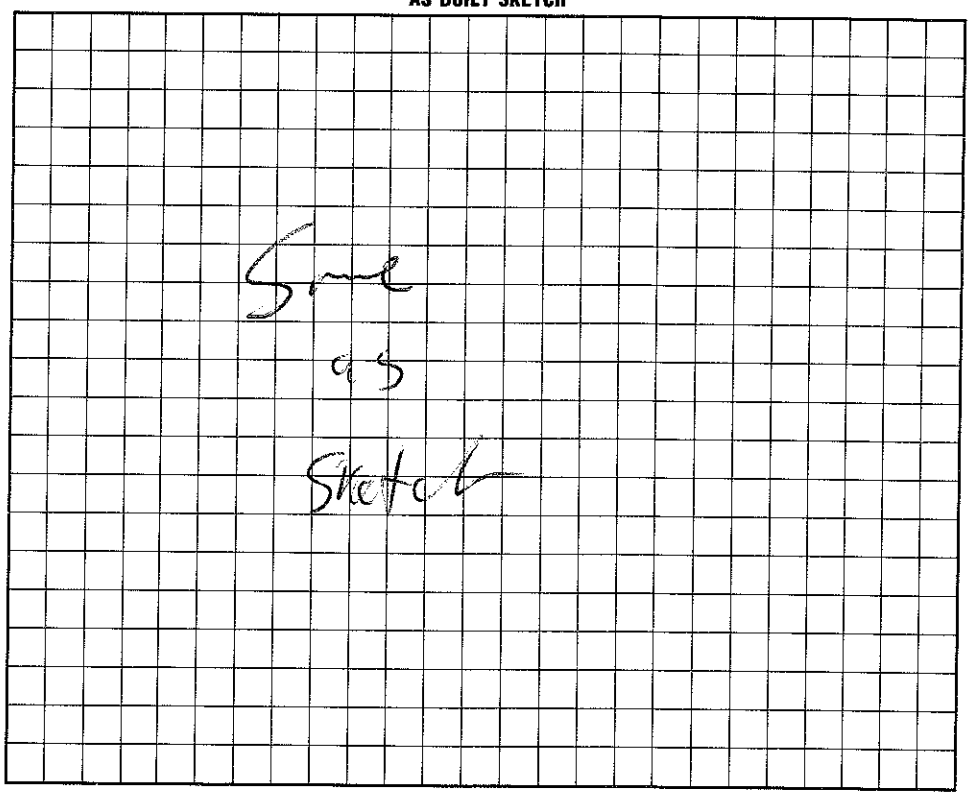

I understand that this permit can be suspended or revoked if any false information is supplied toward securing the permit/any unauthorized changes are made to the site/any unauthorized changes are made in the installation of the system.

Signed: Ernest Allen Stafford

Improvement Permit by: C. Ray Tenn EHST date 9/4/96

AUTH. TO CONSTRUCT Existing System Inspection by: C. Ray Tenn EHST date 9/4/96

Installed by: FJ Ervin

Certificate of Completion by: _____ date _____

Operation Permit by: C. Ray Tenn date 5/28/97

HEALTH DEPT. COPY: WHITE INSPECTION COPY (FINAL): GREEN OWNER COPY (FINAL): YELLOW INSPECTION COPY (INITIAL): PINK OWNER COPY (INITIAL): GOLD