IREDELL COUNTY HEALTH DEPARTMENT

STATESVILLE 704-878-5305 MOORESVILLE 704-664-5281

IMPROVEMENT PERMIT / AUTHORIZATION TO CONSTRUCT / OPERATION PERMIT / EXISTING SYSTEM INSPECTION

PERMIT# 118309 PIN# 4636-86-4412 DATE 8/30/04

OWNER OR CONTRACTOR Heritage Homes of the Carolinas, Inc PHONE: Business 704-309-5452 Home

ADDRESS PO Box 3333 Mooresville NC 28117

LOCATION BSR TL Canvasback, TR Old Squaw, TL Billy Joe, on Lt

SUBDIVISION Mallard Head BLOCK / SECTION LOT 108 LOT AREA 20,000 Ft2 SITE CLASS. PS DESIGN FLOW 480 L.T.A.R. 0.3

Septic Tank: 1000 Gallons; STB 350 Date

Pump Tank: Gallons; PT Date

Pump Make: Model Serial No.

Nitrification Field: No Fields 1 Square Feet 1200 Linear Feet 400

No Lines 8@50' Trench Width 36" Max Trench Bottom Depth 24"

☒ New System ☐ Repair System Type: I II III IV V VI

System Description: Gravity 25% Reduction

Repair System Description: <100% - Deed Prior to 1983

Maintenance Agreement Required: ☐ Yes ☒ No

Gravel Depth —

☒ House/Mod. Home ☐ Mobile Home ☐ Business ☐ Other

No. Bedrooms 4 No. Bathrooms 4 No. Employees


☐ Slab ☒ Crawl Space ☐ Basement w/plumbing ☐ Basement wo/plumbing

Water Supply: ☐ Individual ☐ Public ☒ Community


Comments:/Conditions:

Comments:/Conditions:

INITIAL SITE SKETCH

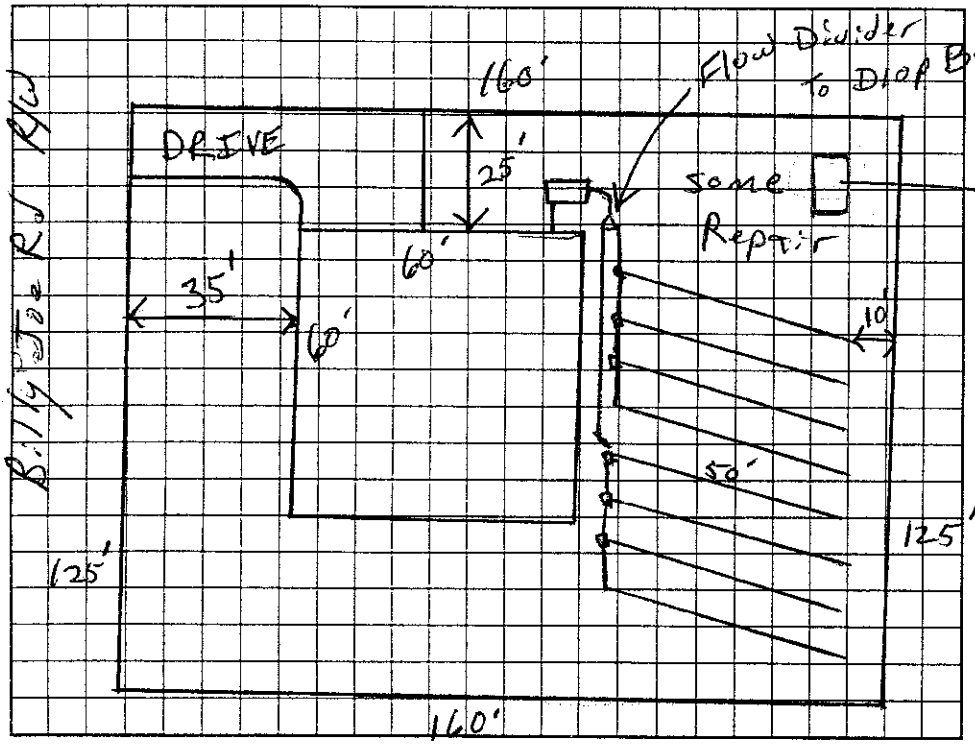

AS BUILT SKETCH

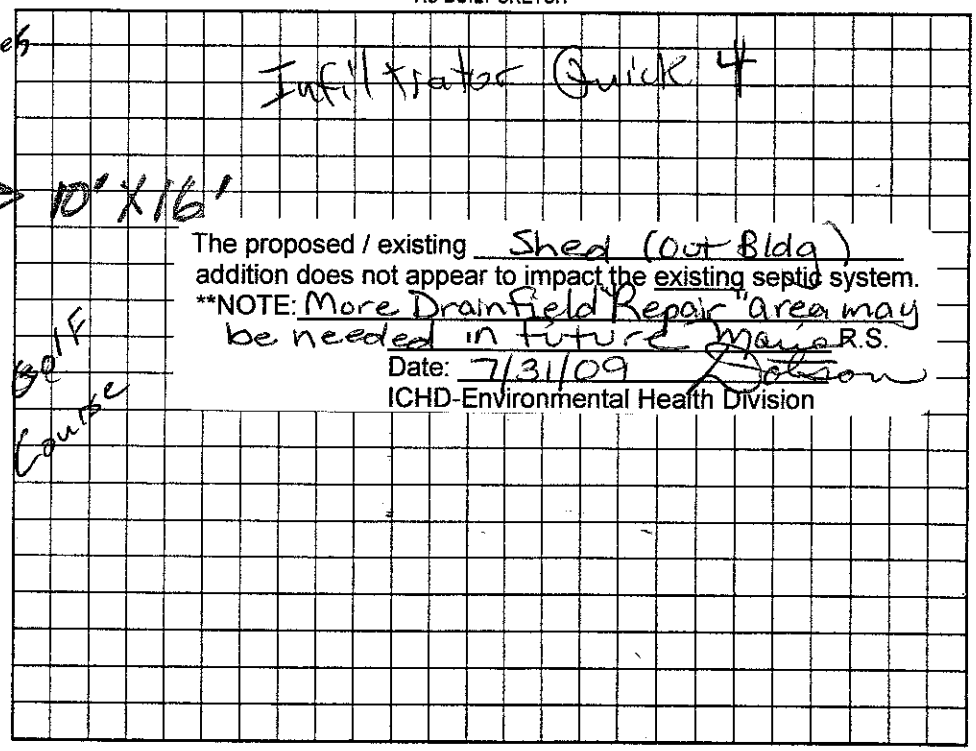

The proposed / existing Shed (Out Bldg) addition does not appear to impact the existing septic system.

**NOTE: More Drainfield Repair "area may be needed in future

Date: 7/31/09 R.S.

ICHD-Environmental Health Division

Permit can be suspended or revoked if any false information is supplied toward securing the permit/any unauthorized changes are made to the site/any unauthorized changes are made in the installation of the system. Improvement Permit with plat valid without expiration. Improvement Permit with site plan valid for sixty months. Authorization to Construct is valid for a period equal to that of Improvement Permit – not to exceed sixty months.

Signed: date 9-17-04 Installed by: Piedmont Septic

Improvement Permit by: RS date 8/30/04 Operation Permit by: RS date 4/12/06

Authorization to Construct by: RS date 11/18/05 Existing System Inspection by: date

HEALTH DEPT. COPY: WHITE OWNER COPY (FINAL): YELLOW OWNER COPY (INITIAL): PINK