IREDELL COUNTY HEALTH DEPARTMENT

STATESVILLE 704-878-5305 MOORESVILLE 704-664-5281

IMPROVEMENT PERMIT / AUTHORIZATION TO CONSTRUCT / OPERATION PERMIT / EXISTING SYSTEM INSPECTION

PERMIT# 070253 PIN# ~~4636858902~~ 4636-86-8474 DATE Sept. 26, '98

OWNER OR CONTRACTOR Guy D. Smith PHONE: Business 363-2291 Home

ADDRESS 104 Scenic Dr. - Apt. D. Mooresville

LOCATION Brawley Sch. Rd. TL on Canvasback RN Right pack 2nd wood Duck loop

SUBDIVISION Mallard Head BLOCK / SECTION LOT 86 LOT AREA 125'x160' SITE CLASS. RS DESIGN FLOW 480gpd L.T.A.R. .03 per AWS permit

Septic Tank: 1000 Gallons; STB 794 Date 11/1/98

Pump Tank: @ Gallons; PT Date

Pump Make: Model Serial No.

Nitrification Field: No Fields 1 Square Feet 1200 Linear Feet 400

No Lines 4@100' Trench Width 36" Max Trench Bottom Depth 30" Gravel Depth N/A

☑ New System ☐ ~~Repair~~ System Type: I, II, III, IV, V, VI

System Description: Gravity 25% Reduction Rock Block

Repair System Description:

Maintenance Agreement Required: ☐ Yes ☑ ~~No~~

☑ House/Mod. Home No. Bedrooms 4

☐ Mobile Home No. Bathrooms 3

☐ Business No. Employees

☐ Other


☐ Slab ☑ Crawl Space ☐ Basement w/plumbing ☐ Basement wo/plumbing

Water Supply: ☐ Individual ☐ ~~Public~~ ☐ ~~Community~~

Comments:/Conditions: *ONE INSpection port per LATERAL

Comments:/Conditions:

INITIAL SITE SKETCH 1"=50'

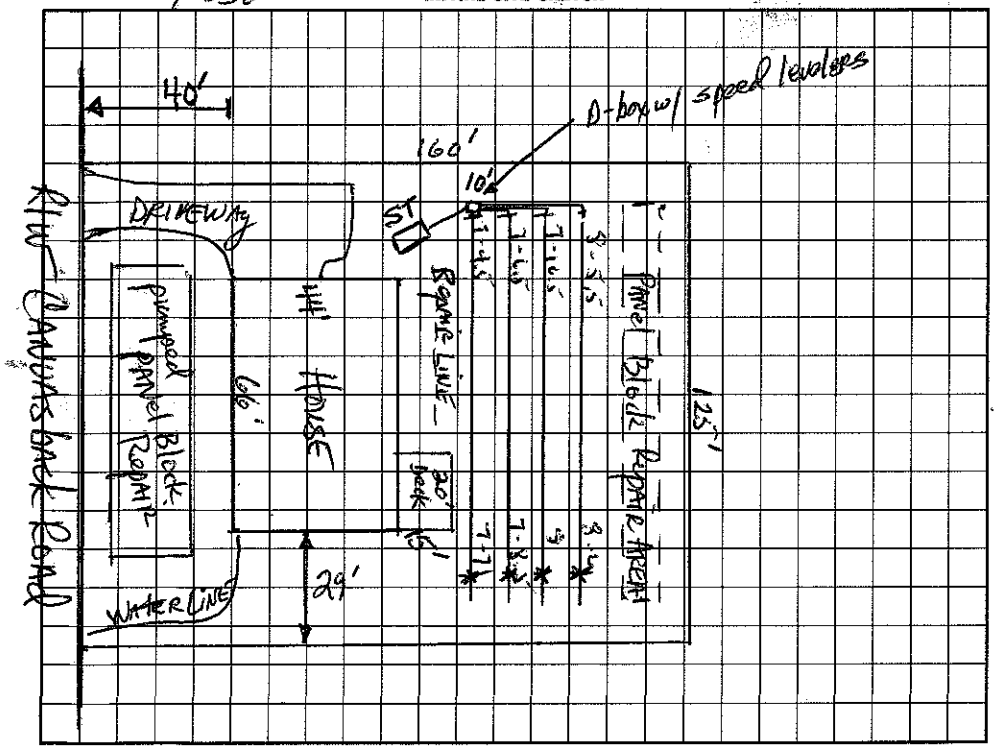

AS BUILT SKETCH

I understand that this permit can be suspended or revoked if any false information is supplied toward securing the permit/any unauthorized changes are made to the site/any unauthorized changes are made in the installation of the system. Improvement Permit with plat valid without expiration. Improvement Permit with site plan valid for sixty months. Authorization to Construct is valid for a period equal to that of Improvement Permit – not to exceed sixty months.

Signed: date 10-26-98 Installed by: Wayne Clontz

Improvement Permit by: Mark S. Hamm, RS date 9-26-98 Operation Permit by: Wesley Sparks RS date 2/15/99

Authorization to Construct by: Mark S. Hamm, RS date 9-26-98 Existing System Inspection by: date

HEALTH DEPT. COPY: WHITE INSPECTION COPY (FINAL): GREEN OWNER COPY (FINAL): YELLOW INSPECTION COPY (INITIAL): PINK OWNER COPY (INITIAL): GOLD