IREDELL COUNTY HEALTH DEPARTMENT

(363-0155) STATESVILLE 704-878-5305 (230-3100) MOORESVILLE 704-664-5281

IMPROVEMENT PERMIT / AUTHORIZATION TO CONSTRUCT / OPERATION PERMIT / EXISTING SYSTEM INSPECTION

PERMIT# 077316 PIN# 4636868474 DATE 11-12-98

OWNER OR CONTRACTOR Lyle Calkins PHONE: Business (704) 361-6609 Home

ADDRESS 139 Pin Oak Ln. Mooresville NC 28117

LOCATION Brawley School Rd TL Canvasback 1/2 mile on Rt.

SUBDIVISION Mallard Head BLOCK / SECTION LOT 82 LOT AREA .49 Acre SITE CLASS. PS DESIGN FLOW 360gpd T.A.R. .3

Septic Tank: 1000 Gallons; STB 794 Date 9/19/99
Pump Tank: Gallons; PT Date
Pump Make: Model Serial No.
Nitrification Field: No Fields 1 Square Feet 1200' Linear Feet 400'
No Lines 6 @ 67' Trench Width 36" Max Trench Bottom Depth 36" Gravel Depth 12"

☒ New System ☐ Repair System Type: I, II, III, IV, V, VI
System Description: Gravity - Conventional
Repair System Description: Gravity - Mod. Bed
Maintenance Agreement Required: ☐ Yes ☒ No


☒ House/Mod. Home No. Bedrooms 3
☐ Mobile Home No. Bathrooms 2
☐ Business No. Employees
☐ Other
☐ Slab ☒ Crawl Space ☐ Basement w/plumbing ☐ Basement wo/plumbing

Water Supply: ☐ Individual ☐ Public ☒ Community

Comments:/Conditions: Keep Septic System at least 10' From PL & 5' From House.

Comments:/Conditions:

INITIAL SITE SKETCH Scale 1:30 **AS BUILT SKETCH**

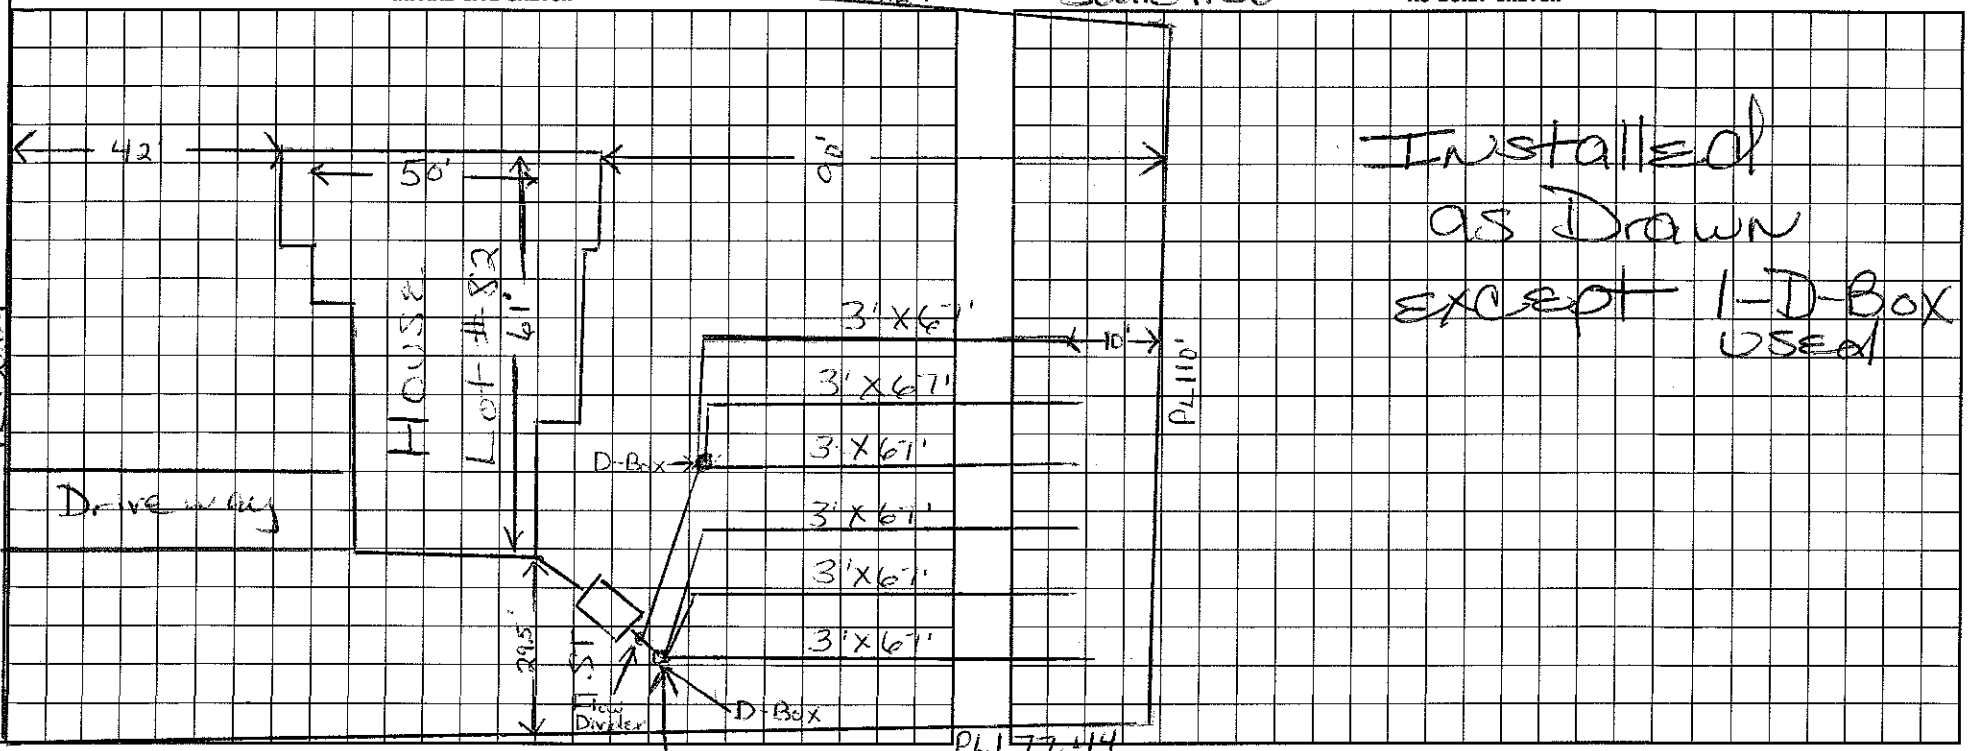

I understand that this permit can be suspended or revoked if any false information is supplied toward securing the permit/any unauthorized changes are made to the site/any unauthorized changes are made in the installation of the system. Improvement Permit with plat valid without expiration. Improvement Permit with site plan valid for sixty months. Authorization to Construct is valid for a period equal to that of Improvement Permit – not to exceed sixty months.

Signed: [signature] date 11/12/98

Improvement Permit by: Maria H.H. Dotson date 11/12/98

Authorization to Construct by: Maria H.H. Dotson date 11/12/98

Installed by: B.W Christenbury

Operation Permit by: Maria H.H. Dotson date 10/29/99

Existing System Inspection by: date

HEALTH DEPT. COPY: WHITE INSPECTION COPY (FINAL): GREEN OWNER COPY (FINAL): YELLOW INSPECTION COPY (INITIAL): PINK OWNER COPY (INITIAL): GOLD