4636-86-8576

IREDELL COUNTY HEALTH DEPARTMENT

STATESVILLE 704-878-5305 MOORESVILLE 704-664-5281

IMPROVEMENT PERMIT / CERTIFICATE OF COMPLETION / OPERATION PERMIT / EXISTING SYSTEM INSPECTION

PROPERTY DESCRIPTION NO. 16374 DATE July 9, 193 TAX MAP NO. 2K-9-A-81

OWNER OR CONTRACTOR Speer Const. PHONE: Business 636-7954 Home

ADDRESS 607 Anderson Ave Salisbury NC 28144

LOCATION SR 1160 TL 1179 (Cannonsdale) on Lt w 5th lot past Old Squaw Trail

SUBDIVISION Mallard Head BLOCK / SECTION LOT 81 LOT AREA 1254/160 SITE CLASS. PST L.T.A.R. .35 gal/ft²/day

Water Supply: ☐ Individual ☑ Community ☐ Public

Septic Tank: 1250 Gallons; STB 1013 RST Date 5-5-93

Pump Tank: Gallons; PT Date

Nitrification Field: ~~No~~ Fields 1 Square Feet 1500 Linear Feet 500

~~No~~ Lines 5 Trench Width 36" Trench Depth 30" Gravel Depth 12"

☑ New System ☐ Repair System Type: I (II) III, IV, V, VI

System Description: gravity conventional

Repair System Description: gravity PBPS

Maintenance Agreement Required: ☐ Yes ☑ No

☑ House/Mod. Home No. Bedrooms 4

☐ Mobile Home No. Bathrooms 2½

☐ Business No. Employees

☐ Other

☐ Slab ☑ Crawl Space ☐ Basement w/plumbing ☐ Basement wo/plumbing

Garbage Disposal: ☐ Yes ☑ No


Auto. Dishwasher: ☑ Yes ☐ No

Auto. Washing Machine: ☑ Yes ☐ No


Other

Comments Exit plumbing from house at or slightly above existing grade in order to accomodate specified trench bottom depth. This permit replaces permit issued for lot 80 due to incorrect info. provided on lot number.

INITIAL SITE SKETCH

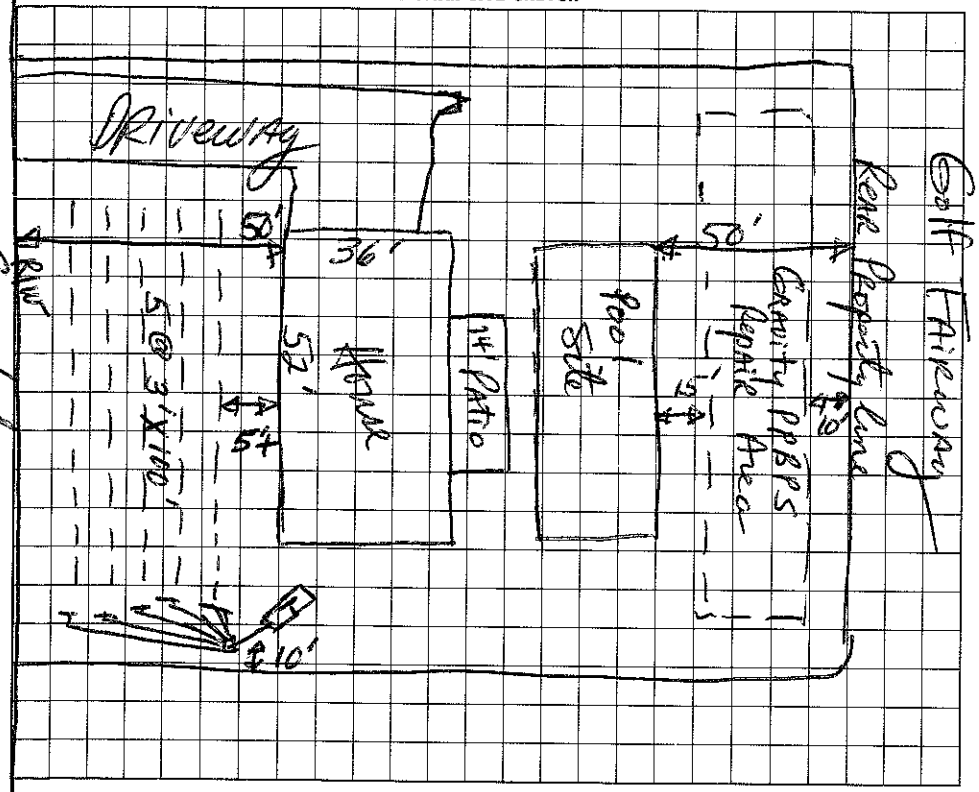

AS BUILT SKETCH

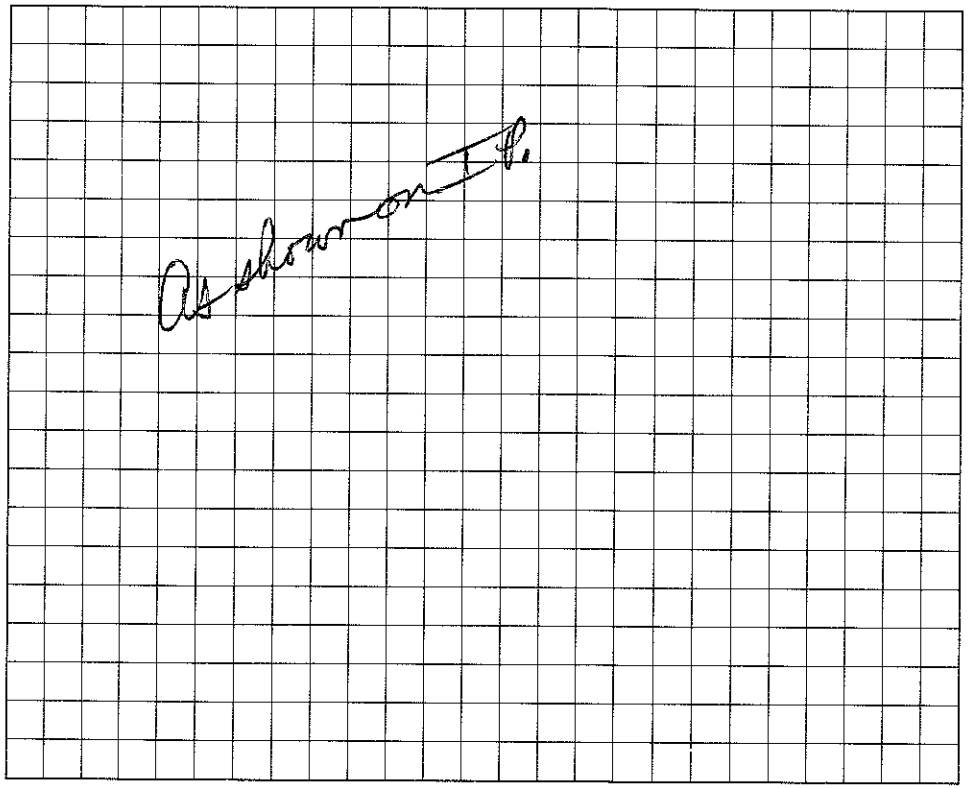

I understand that this permit can be suspended or revoked if any false information is supplied toward securing the permit/any unauthorized changes are made to the site/any unauthorized changes are made in the installation of the system. Improvement Permit is valid for 60 months from date of issuance.

Signed: X

Improvement Permit by: David R. Hinson, RS date 7/9/93

Existing System Inspection by: date

Installed by: Rowan Septic Tank

Certificate of Completion by: D.R. Hinson RS date 9/8/93

Operation Permit by: date

HEALTH DEPT. COPY: WHITE INSPECTION COPY (FINAL): GREEN OWNER COPY (FINAL): YELLOW INSPECTION COPY (INITIAL): PINK OWNER COPY (INITIAL): GOLD