IREDELL COUNTY HEALTH DEPARTMENT

Auth to Construct. 10:30

TATESVILLE 704-878-5305 MOORESVILLE 704-64-5281

IMPROVEMENT PERMIT / ~~CERTIFICATE OF COMPLETION~~ / OPERATION PERMIT / EXISTING SYSTEM INSPECTION

PROPERTY DESCRIPTION NO. 070254 DATE 12/1/97 TAX MAP NO. 4636868912 Watershed: [X] Yes [ ] No

OWNER OR CONTRACTOR John F West PHONE: Business _____ Home _____ WSIVCA

ADDRESS 104060 Summit Squaw Dr. Leesburg, Fla 34788

LOCATION Canvasback Rd. TL Canvasback Rd on (R) after Old Squaw Trail

SUBDIVISION Mallard Head BLOCK / SECTION _____ LOT 78 LOT AREA .5 SITE CLASS PS DESIGN FLOW 360 L.T.A.R. .3

Septic Tank: 1000 Gallons; STB 825 Date 5/3/98

Pump Tank: _____ Gallons; PT _____ Date _____

Pump Make: _____ Model 900 Serial No. 300

Nitrification Field: No Fields 1 Square Feet ~~420~~ Linear Feet 400

No Lines 4 3 Trench Width 36" Max Trench Bottom Depth 36" Gravel Depth 12"

[X] New System [ ] Repair System Type: I, (II) III IV, V, VI

System Description: ~~CONVENTIONAL~~ GRAVITY

Repair System Description: 16" PPBS (CHAMBERS)

Maintenance Agreement Required: [ ] Yes [ ] No

[X] House/Mod. Home No. Bedrooms 3

[ ] Mobile Home No. Bathrooms 2.5

[ ] Business No. Employees ____

[ ] Other _____

[ ] Slab [X] Crawl Space [ ] Basement w/plumbing [ ] Basement wo/plumbing


Water Supply: [ ] Individual [X] Community [ ] Public

Comments:

Comments:

CHANGED TO 3BR CHAMBERS 300' PAID PERMIT DEFFERENCE

INITIAL SITE SKETCH

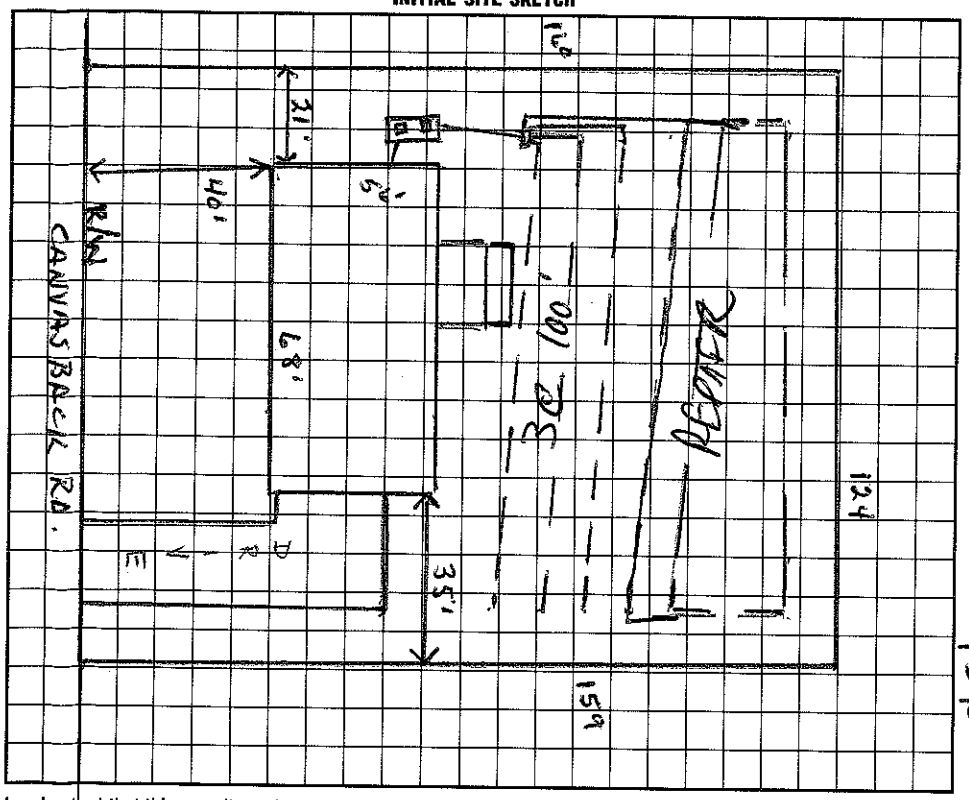

AS BUILT SKETCH

I understand that this permit can be suspended or revoked if any false information is supplied toward securing the permit/any unauthorized changes are made to the site/any unauthorized changes are made in the installation of the system. Improvement Permit is valid for 60 months from date of issuance.

Signed: * Wayne Clontz

Improvement Permit by: Wesley Sparks RS. date 12/1/97

Existing System Inspection by: Wesley Sparks RS. date 12/1/97

Installed by: WAYNE CLONTZ

Certificate of Completion by: _____ date _____

Operation Permit by: C. [illegible] RS date 6/23/98

HEALTH DEPT. COPY: WHITE INSPECTION COPY (FINAL): GREEN OWNER COPY (FINAL): YELLOW INSPECTION COPY (INITIAL): PINK OWNER COPY (INITIAL): GOLD