3130

550.00

IREDELL COUNTY HEALTH DEPARTMENT

STATESVILLE 704-878-5305 MOORESVILLE 704-664-5281

IMPROVEMENT PERMIT / AUTHORIZATION TO CONSTRUCT / OPERATION PERMIT / EXISTING SYSTEM INSPECTION

DATE 2-7-06

PERMIT# 132929 PIN# 4636870221 PHONE: Business 704-896-4229 Home 704-975-4991

OWNER OR APPLICANT Theresa Kelly

ADDRESS 111 Forest Ridge Rd. 140 Old Squaw Tr.

LOCATION Brawley School Rd. TL Canvasback TR old Squaw on right DESIGN FLOW 360 gpd L.T.A.R. .3 gpd/ft²

SUBDIVISION Mallard Head BLOCK / SECTION ____ LOT 43 LOT AREA .45 Ac+Easement SITE CLASS. PS

Septic Tank: 1000 Gallons: STB 1012 Date 8-3-06

Pump Tank: 1000 Gallons: PT 274 Date 10-31-06

Pump Make: Goulds Model PE51 Serial No. ____

Nitrification Field: No Fields 1 Square Feet ____ Linear Feet 300

No Lines 4 Trench Width 36" Max Trench Bottom Depth 36"

☒ New System ☐ Repair ☐ Expansion System Type: I II III IV V VI

System Description: 25% reduction, pump pm

Repair System Description: LP Panel

Maintenance Agreement Required: ☐ Yes ☒ No

Gravel Depth N/A ☐ Gravity ☒ Pressure ☒ Slab ☐ Crawl Space ☐ Basement w/plumbing ☐ Basement wo/plumbing

☒ House/Mod. Home ☐ Mobile Home ☐ Business ☐ Other

No. Bedrooms 3 No. Persons ____ No. Employees ____


Water Supply: ☐ Individual ☐ Public ☒ Community

Comments:/Conditions:


* Where supply line crosses drain maintain 12" separation from gravel or encase pipe in concrete or ductile iron for at least 5' either side of crossing.
Install septic drain lines as drawn.

Comments:/Conditions:

INITIAL SITE SKETCH

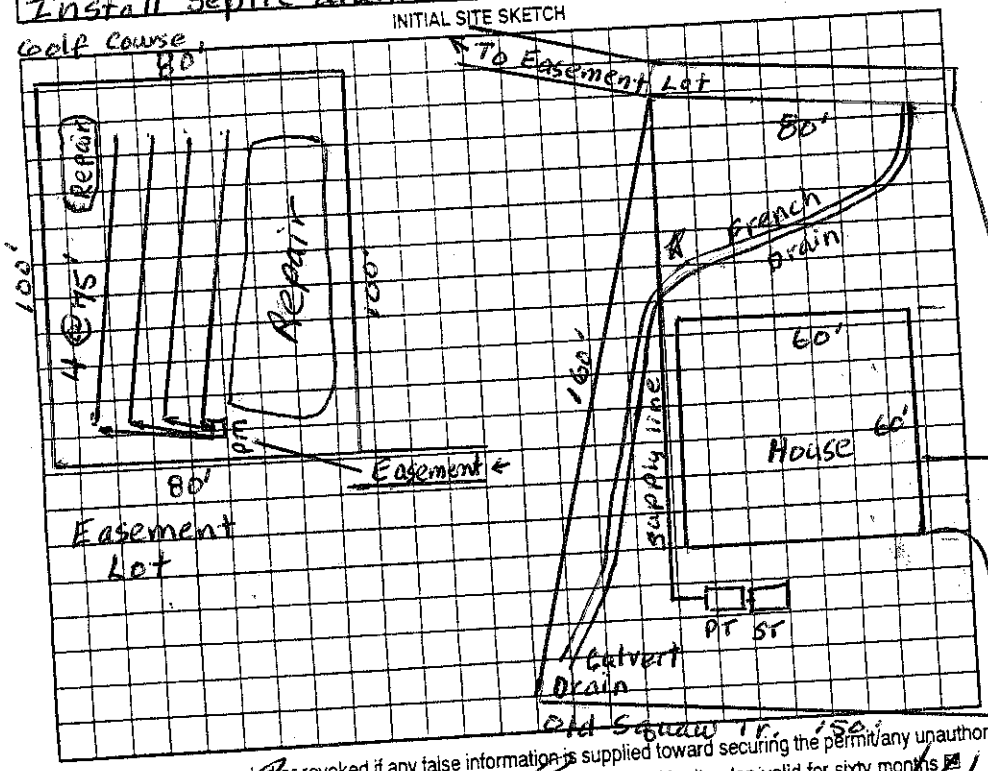

AS BUILT SKETCH

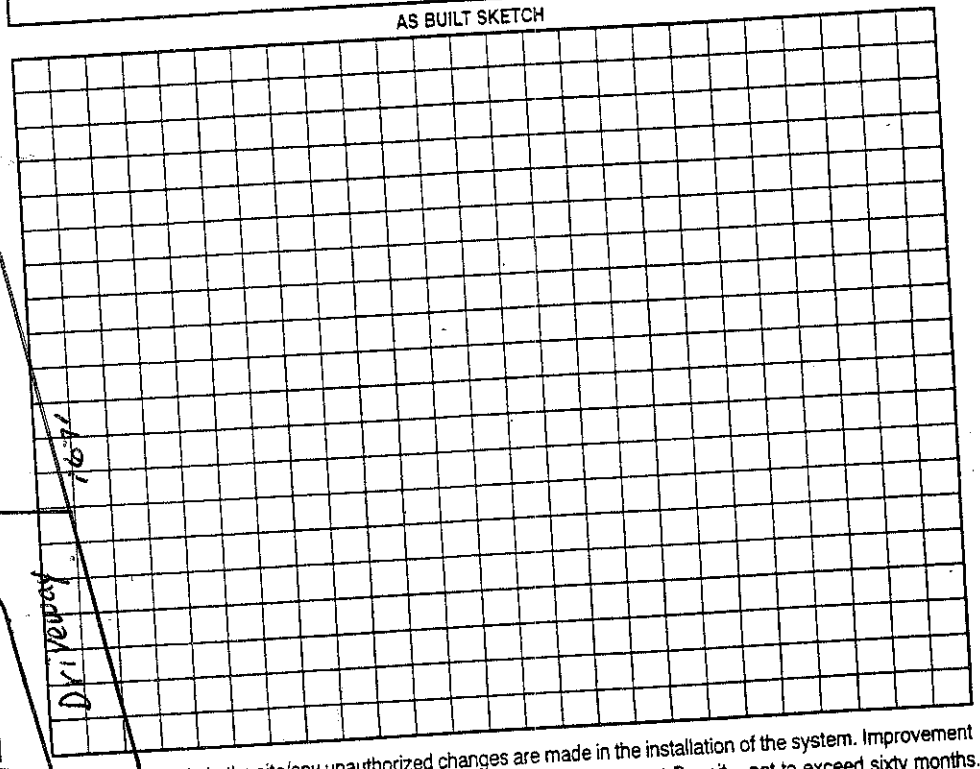

Permit can be suspended or revoked if any false information is supplied toward securing the permit/any unauthorized changes are made to the site/any unauthorized changes are made in the installation of the system. Improvement Permit – not to exceed sixty months. Authorization to Construct is valid for a period equal to that of Improvement Permit

Permit with plat valid without expiration ☐ Improvement Permit with site plan valid for sixty months ☒

Signed: Ginger Flair date 7/11/06 Installed by: ~~Rocean Septic~~ Richard Abernathy date 2/26/07

Improvement Permit by: Judy Melville date 2-7-06 Operation Permit by: ____ date ____

to Construct by: Judy Melville date 2-7-06 Existing System Inspection by: ____

HEALTH DEPT. COPY: WHITE OWNER COPY (FINAL): YELLOW OWNER COPY (INITIAL): PINK