550.00 3:30

IREDELL COUNTY HEALTH DEPARTMENT

STATESVILLE 704-878-5305 MOORESVILLE 704-664-5281

IMPROVEMENT PERMIT / AUTHORIZATION TO CONSTRUCT / OPERATION PERMIT / EXISTING SYSTEM INSPECTION

PERMIT# 132929 PIN# 4636870221

OWNER OR APPLICANT Theresa Kelly DATE 2-7-06

ADDRESS 111 Forest Ridge Rd. PHONE: Business 704-896-4229 Home 704-975-4991

LOCATION Brawley School Rd. TL Canvasback TR Old Squaw on right 140 Old Squaw Tr.

SUBDIVISION Mallard Head BLOCK / SECTION ____ LOT 43 LOT AREA .45 Ac +Easement SITE CLASS. PS DESIGN FLOW 360 gpd L.T.A.R. .3 gpd/ft²

Septic Tank: 1000 Gallons; STB 1012 Date 5-3-06

Pump Tank: 1000 Gallons; PT 274 Date 10-31-06

Pump Make: Goulds Model PG51 Serial No. ____

Nitrification Field: No Fields 1 Square Feet ____ Linear Feet 300

No Lines 4 Trench Width 36" Max Trench Bottom Depth 36" Gravel Depth N/A

☒ New System ☐ Repair ☐ Expansion System Type: I II III IV V VI

System Description: 25% reduction, pump pmp

Repair System Description: LP Panel

Maintenance Agreement Required: ☐ Yes ☒ No

☒ House/Mod. Home ☐ Mobile Home ☐ Business ☐ Other

No. Bedrooms 3 No. Persons ____ No. Employees ____


Water Supply: ☐ Individual ☐ Public ☒ Community

☐ Gravity ☒ Pressure ☒ Slab ☐ Crawl Space ☐ Basement w/plumbing ☐ Basement wo/plumbing


Comments:/Conditions: * Where supply line crosses drain maintain 12" separation from gravel or encase pipe in concrete or ductile iron for at least 5' either side of crossing. Install septic drain lines as drawn.

Comments:/Conditions:

INITIAL SITE SKETCH

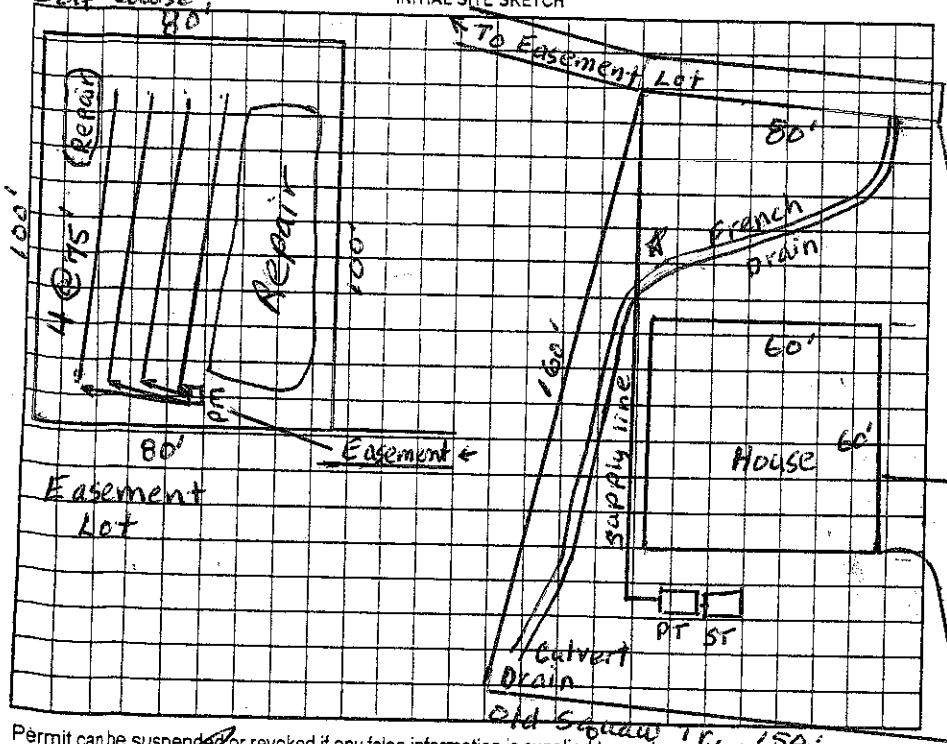

AS BUILT SKETCH

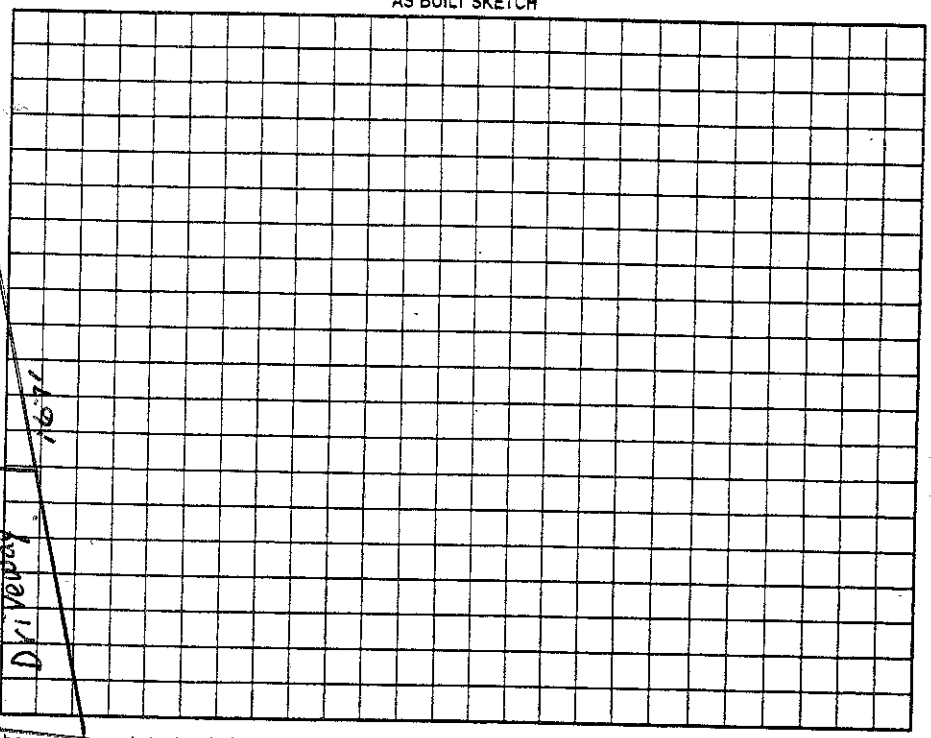

Permit can be suspended or revoked if any false information is supplied toward securing the permit/any unauthorized changes are made to the site/any unauthorized changes are made in the installation of the system. Improvement Permit with plat valid without expiration ☐ Improvement Permit with site plan valid for sixty months ☒ Authorization to Construct is valid for a period equal to that of Improvement Permit – not to exceed sixty months.

Signed: Angel Flair date 7/11/06 Installed by: ~~Rocan Septic~~ Richard Abernathy

Improvement Permit by: Judy Melville date 2-7-06 Operation Permit by: John Ann date 2/26/07

Authorization to Construct by: Judy Melville date 2-7-06 Existing System Inspection by: ____ date ____

HEALTH DEPT. COPY: WHITE OWNER COPY (FINAL): YELLOW OWNER COPY (INITIAL): PINK