CW

ICHD - ENVIRONMENTAL HEALTH DIVISION

Statesville Office (704) 878-5305 | Mooresville Office (704) 660-3625 | PERMIT # OSWP 2023-436 41

SEPTIC: IMPROVEMENT PERMIT / AUTHORIZATION TO CONSTRUCT / OPERATION PERMIT / EXISTING SYSTEM

PIN # 4636 -- 87 -- 0970 ✓

APPLICANT/OWNER: Jeanie Lentz | APPLICANT ADDRESS: 463 Lentz Rd, Statesville 28625

SITE ADDRESS: 129 Webbed Foot Rd, Mooresville 28117 ✓ | PHONE: 980-829-3278 | ALT. PHONE —

SITE DIRECTIONS: BSR - ⓒ Webbed Foot Rd - Lot on ⓡ | SAP CONTROLLED: ☐ ~~YES~~ ☐ ~~NO~~


SUBDIVISION: Mallard Head Country Club ✓ | SECTION: 1 ✓ | LOT # 30 ✓ | LOT AREA: 0.47 | DESIGN FLOW: EX. | L.T.A.R.: EX.

Septic Tank	1000 (gal)	STB	760	Date	10-22-23	☐ New System	☑ Repair	☐ Expansion	System Type: I (II) III IV V VI
Pump Tank	— (gal)	PT		Date		System Description:			
Pump Make		Model		Serial #		Repair System Description:	Tank Replacement		
# Nitrification Fields	EX	# Lines	EX	Linear Ft	EX	Maintenance Agreement Required:	☐ YES	☑ NO	
Trench Width	EX.	Trench Bottom Depth(Low side)	EX	Gravel Depth	—	☑ GRAVITY	☐ PRESSURE		

☑ Residence	No. Bedrooms	3	**Water Supply**		
☐ Business	No. Persons	6	☐ Private		
☐ Other	No. Employees		☑ Public		
☐ Slab	☐ Crawl Space		☐ Community		
☐ Basement w/plumbing			☐ Basement w/o plumbing		

Comments / Conditions: Pump, crush, & fill old tank. Replace distribution as needed.

INITIAL SITE SKETCH

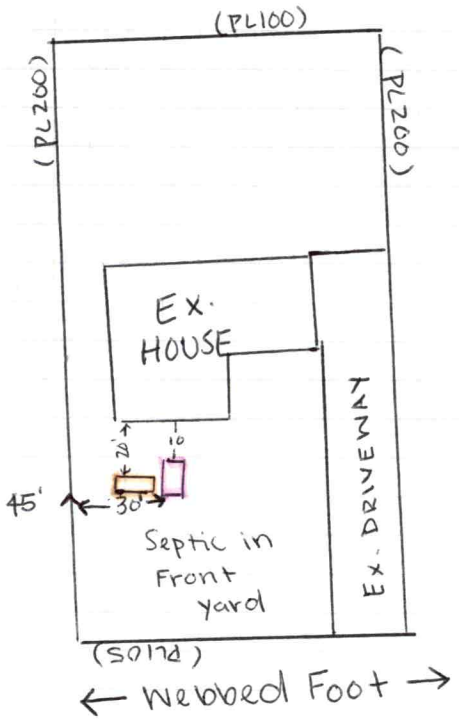

AS BUILT SKETCH

FOR SEPTIC FINAL INSPECTION CALL: 704-664-3703 between 8am-9am the day the inspection is needed. Be sure to speak with an inspector to confirm your time.

1" = 60'

old S.T

New S.T

Permit can be suspended or revoked if any false information is supplied toward securing the permit / any unauthorized changes are made to the site / any unauthorized changes are made in the installation of the system. **CONTACT A LOCATOR SERVICE PRIOR TO ANY EXCAVATION**

☐ **IMPROVEMENT PERMIT** ***with plat*** *valid without expiration.* ☑ **IMPROVEMENT PERMIT** ***with site plan*** *valid for 60 mos.* ☑ **AUTHORIZATION TO CONSTRUCT** *valid for period equal to IMPROVEMENT PERMIT--not to exceed 60 mo.*

Owner / Applicant Signature: Online | Date: — | Installed by: Lentz

IMPROVEMENT PERMIT by: Sydney Holland | Date: 12/28/23 | OPERATION PERMIT by: Sydney Holland | Date: 1-11-24

AUTHORIZATION TO CONSTRUCT by: Sydney Holland | Date: 12/28/23 | Existing System Inspected by: | Date:

FOR SEPTIC FINAL INSPECTION: CALL 704-664-3703 between 8am-9am the day the inspection is needed.