IREDELL COUNTY HEALTH DEPARTMENT

4636-87-4049 2132

STATESVILLE 704-878-5305 MOORESVILLE 704-664-5281

IMPROVEMENT PERMIT / AUTHORIZATION TO CONSTRUCT / OPERATION PERMIT / EXISTING SYSTEM INSPECTI

PERMIT# 101335 PIN# 4636574049 Jeff DATE 4-29-0

OWNER OR CONTRACTOR EFC Assoc. Inc PHONE: Business 239-2022 Home

ADDRESS 101 Castles Gate Dr Mooresville, NC 28117

LOCATION Brawley School Rd TL Canvasback TR Old Squaw 3lot on left

SUBDIVISION Mallard Head BLOCK / SECTION 1 LOT 74 LOT AREA .465 SITE CLASS. PS DESIGN FLOW 360 L.T.A.R. .25-.3

Septic Tank: 1000 Gallons; STB 794 Date 6-16-04 ☒ New System ☐ Repair System Type: I (II) III IV V VI

Pump Tank: Gallons; PT Date

Pump Make: Model Serial No.

Nitrification Field: No Fields 1 Square Feet 900 Linear Feet 300'

No Lines 6@50' Trench Width 36" Max Trench Bottom Depth 36" Gravel Depth N/A

System Description: Gravity - 25% Reduction

Repair System Description: Panel Block

Maintenance Agreement Required: ☐ Yes ☒ No

☒ House/Mod. Home No. Bedrooms 3

☐ Mobile Home No. Bathrooms 2.5

☐ Business No. Employees

☐ Other


☐ Slab ☒ Crawl Space ☐ Basement w/plumbing ☐ Basement wo/plumbing

Water Suppl ☐ Individual ☒ Public ☐ Communi

Comments:/Conditions: Keep Septic System at least 10' from PL & 15' From Cut 25ft or greater

Comments:/Conditions:

INITIAL SITE SKETCH Scale 1:40

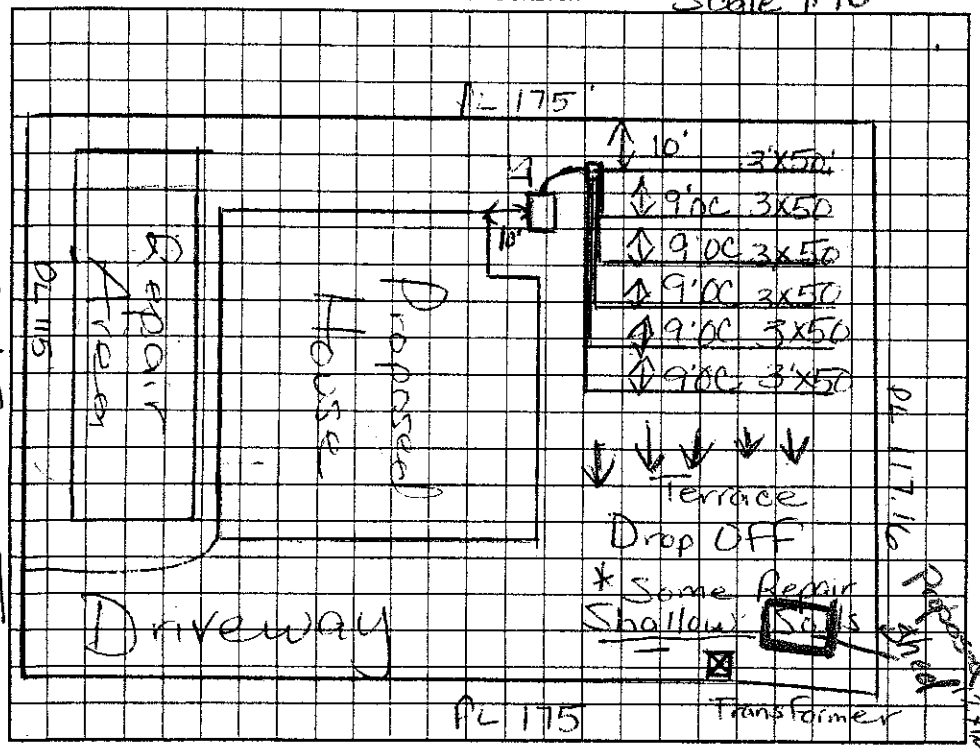

AS BUILT SKETCH

Installed "Plastic Chambers As Drawn

The proposed / existing Out bldg. / Shed addition does not appear to impact the existing septic system.

**NOTE: Keep Shed/Bldg at least 5ft from Septic R.S.

Date: 12-15-09

ICHD-Environmental Health Division

Permit can be suspended or revoked if any false information is supplied toward securing the permit/any unauthorized changes are made to the site/any unauthorized changes are made in the installation of the system. Improveme Permit with plat valid without expiration. Improvement Permit with site plan valid for sixty months. Authorization to Construct is valid for a period equal to that of Improvement Permit – not to exceed sixty months.

Signed: DM Bowen date 4/30/04 Installed by: Upright Gradings

Improvement Permit by: Maria H.H. Dotson R.S. date 4/30/04 Operation Permit by: Maria H.H. Dotson R.S. date 7/21/

Authorization to Construct by: Maria H.H. Dotson R.S. date 4/30/04 Existing System Inspection by: date

HEALTH DEPT. COPY: WHITE OWNER COPY (FINAL): YELLOW OWNER COPY (INITIAL): PINK