IREDELL COUNTY HEALTH DEPARTMENT

STATESVILLE 704-878-5305 MOORESVILLE 704-664-5281

IMPROVEMENT PERMIT / AUTHORIZATION TO CONSTRUCT / OPERATION PERMIT / EXISTING SYSTEM INSPECTIO.

11:30

PERMIT# 093233 PIN# 4636875173 DATE 12/18/2000

OWNER OR CONTRACTOR Ralph Williams / Jeffrey Mays (Jeff) PHONE: Business 784-4218 Home Joan 423-4038

ADDRESS 275 Zephyr Mountain Park Rd. State Road, NC, 28676

LOCATION Brawley School Rd TL Canvasback

SUBDIVISION Mallard Head BLOCK / SECTION ____ LOT 75 LOT AREA ____ SITE CLASS. PS DESIGN FLOW 480 gpd L.T.A.R. .3

Septic Tank: 1000 Gallons; STB 825 Date 4-1-01
Pump Tank: 1000 Gallons; PT 302 Date 1-8-01
Pump Make: Zoeller Model N98 Serial No. ____
Nitrification Field: No. Fields 1 Square Feet 1200' Linear Feet 400'
No. Lines 5 at 80' Trench Width 36" Max Trench Bottom Depth 24" Gravel Depth N/A

[X] New System [ ] Repair System Type: I, II, III, IV, V, VI
System Description: Pump-PM-25% Reduct
Repair System Description: Pump Panel Block
Maintenance Agreement Required: [ ] Yes [X] No Not Initially


[X] House/Mod. Home No. Bedrooms 4
[ ] Mobile Home No. Bathrooms 3
[ ] Business No. Employees ____
[ ] Other ____
[ ] Slab [X] Crawl Space [ ] Basement w/plumbing [ ] Basement wo/plumbing

Water Supply: [ ] Individual [X] Public [X] Community


Comments:/Conditions: Keep Drainfield within Septic Easement boundaries. Septic/Pumptank must be at least 10' From PL, 5' from House & 15' From Pool

Comments:/Conditions: Note: Per Zoning Dept. must keep Pool at least 10' from House & 10' From PL. Filter installed. Good job on installation of Drainfield.

INITIAL SITE SKETCH Scale 1:40'

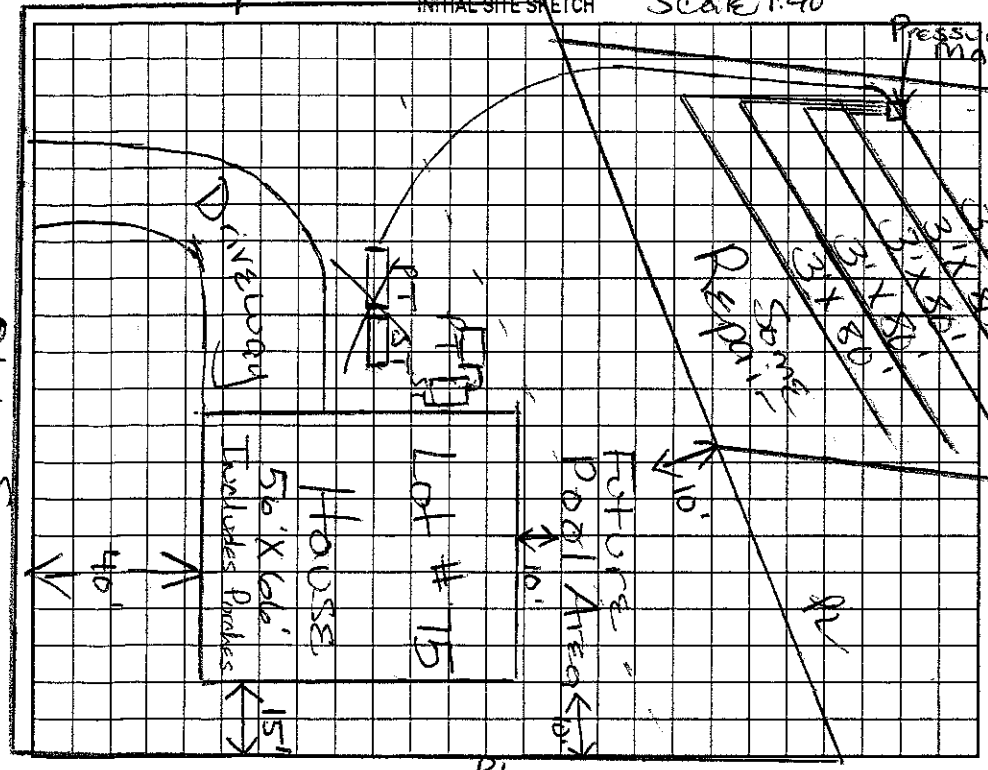

AS BUILT SKETCH

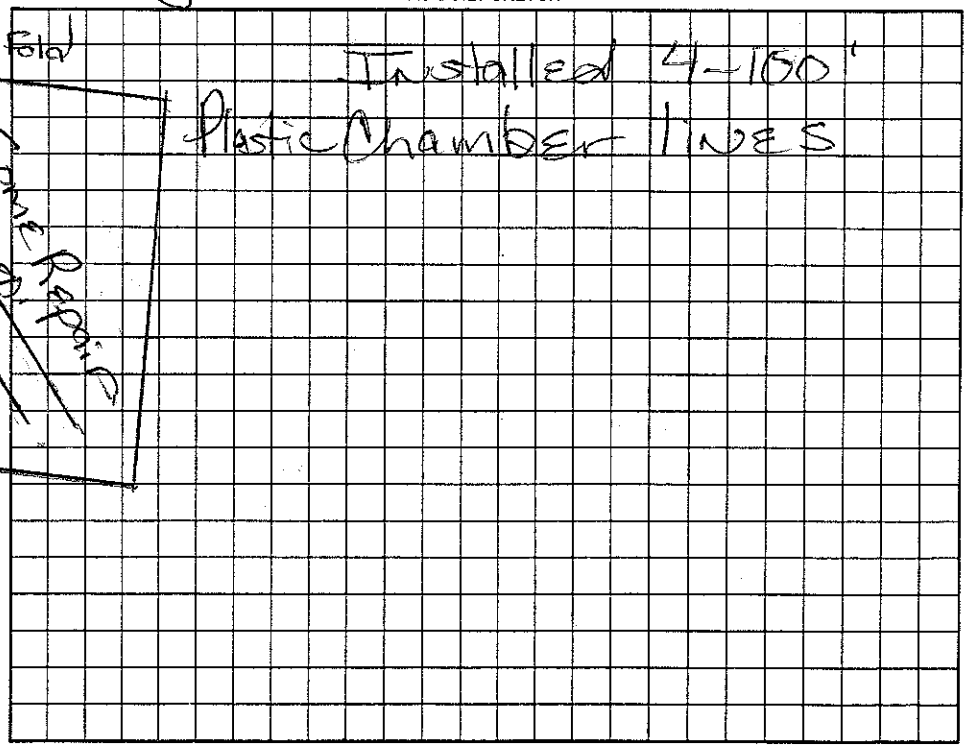

Old Sauau

Permit can be suspended or revoked if any false information is supplied toward securing the permit/any unauthorized changes are made to the site/any unauthorized changes are made in the installation of the system. Improvement Permit with plat valid without expiration. Improvement Permit with site plan valid for sixty months. Authorization to Construct is valid for a period equal to that of Improvement Permit – not to exceed sixty months.

Signed: Jeffrey Mays date 12/21/00 Installed by: Rowan Septic

Improvement Permit by: Maria H. Dotson R.S. date 12/19/2000 Operation Permit by: [signature] R.S. date 7/13/01

Authorization to Construct by: Maria H. Dotson R.S. date 12/19/2000 Existing System Inspection by: ____ date ____

HEALTH DEPT. COPY: WHITE OWNER COPY (FINAL): YELLOW OWNER COPY (INITIAL): PINK