IREDELL COUNTY HEALTH DEPARTMENT

STATESVILLE 704-878-5305 MOORESVILLE 704-664-5281

IMPROVEMENT PERMIT / CERTIFICATE OF COMPLETION / OPERATION PERMIT / EXISTING SYSTEM INSPECTION

PROPERTY DESCRIPTION NO. ~~2K 9A 38~~ 17083 DATE Sept. 27, '93 TAX MAP NO. 2K-9A-38

OWNER OR CONTRACTOR Doris G. Skeen ~~PHONE: Business~~ 463-87-6306 Home 664-3342

ADDRESS PO Box 934 Mooresville

LOCATION HWY 21 N to 1179 TR Old Square 2nd lot on Right

SUBDIVISION Mallard Head BLOCK / SECTION 1 LOT 38 LOT AREA 120' x 167' SITE CLASS. PS L.T.A.R. .3 gal/ft²/day

Water Supply: ☐ Individual ☐ Community ☐ Public

Septic Tank: 1000 Gallons; STB 794 Dellinger Date 1-13-94

Pump Tank: _____ Gallons; PT _____ Date _____

Nitrification Field: No. Fields 2 Square Feet 1200 Linear Feet 400

No. Lines 8 Trench Width 36" Trench Depth 36" Gravel Depth 12"

☑ New System ☐ Repair System Type: I II III IV V VI

System Description: Gravity Conventional

Repair System Description: Gravity PPBPS or LPS

Maintenance Agreement Required: ☐ Yes ☑ No

☑ House/Mod. Home No. Bedrooms 3

☐ Mobile Home No. Bathrooms 2

☐ Business No. Employees _____

☐ Other _____

☐ Slab ☑ Crawl Space ☐ Basement w/plumbing ☐ Basement wo/plumbing

Garbage Disposal: ☑ Yes ☐ No


Auto. Dishwasher: ☑ Yes ☐ No

Auto. Washing Machine: ☑ Yes ☐ No


Other _____

Comments _____

INITIAL SITE SKETCH

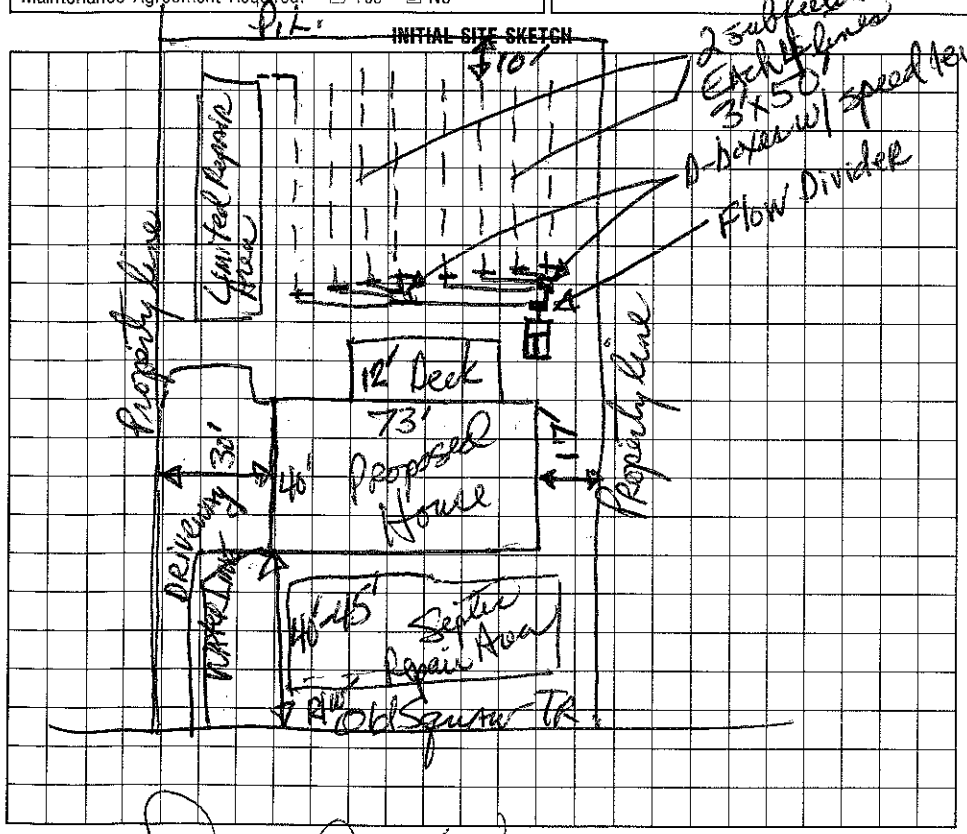

AS BUILT SKETCH

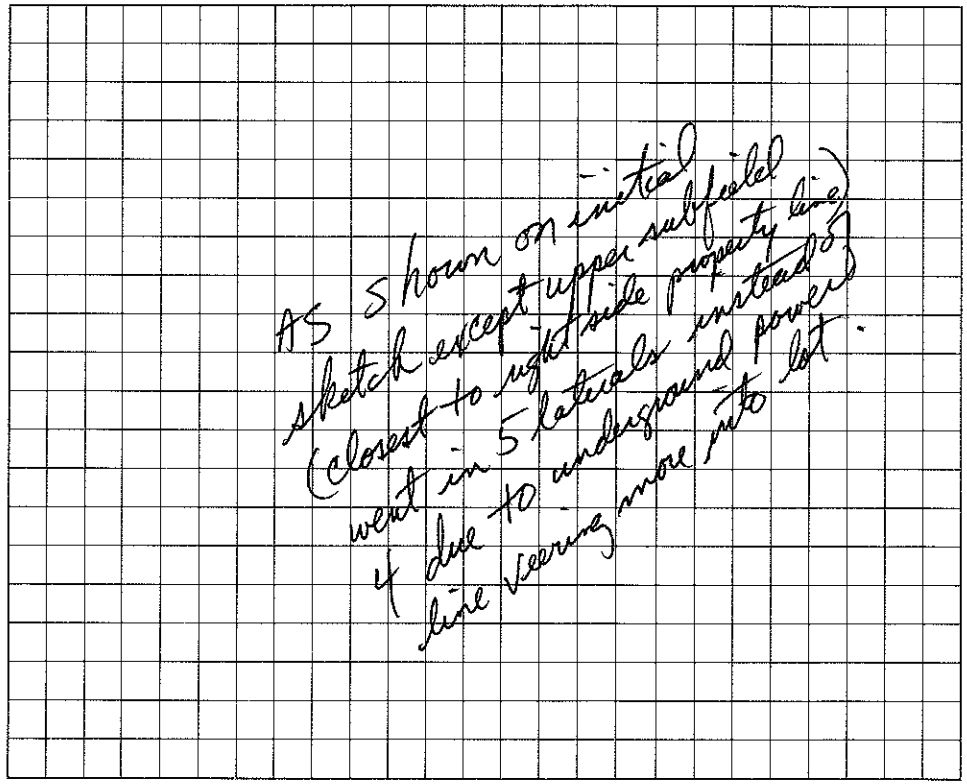

I understand that this permit can be suspended or revoked if any false information is supplied toward securing the permit/any unauthorized changes are made to the site/any unauthorized changes are made in the installation of the system. Improvement Permit is valid for 60 months from date of issuance.

Signed: Doris G. Skeen

Improvement Permit by: Jane R. Hinson, RS date 9/27/93

Existing System Inspection by: _____ date _____

Installed by: _____

Certificate of Completion by: Jane R. Hinson, RS date 2/21/94

Operation Permit by: _____ date _____

HEALTH DEPT. COPY: WHITE INSPECTION COPY (FINAL): GREEN OWNER COPY (FINAL): YELLOW INSPECTION COPY (INITIAL): PINK OWNER COPY (INITIAL): GOLD