IREDELL COUNTY HEALTH DEPARTMENT

Statesville Office (704) 878-5305 Mooresville Office (704) 660-3625 PERMIT # 179429

IMPROVEMENT PERMIT / AUTHORIZATION TO CONSTRUCT / OPERATION PERMIT / EXISTING SYSTEM

PIN # 4636876794

APPLICANT: JENAPER HILL LLC APPLICANT ADDRESS: PO BOX 5351 MOORESVILLE 28117

SITE ADDRESS: WEBBED FOOT DRIVE PHONE: ALT. PHONE:

SITE DIRECTIONS: BRAWLEY SCHOOL - TL CANVASBACK - CORNER OF WEBBED FOOT.

SUBDIVISION: MALLARD HEAD SECTION: LOT # 36 LOT AREA: DESIGN FLOW: 480 GPD L.T.A.R.: .25

Septic Tank 1000 (gal) STB 1012 Date 10-22-13

Pump Tank (gal) PT Date

Pump Make Model Serial #

Nitrification Fields 1 # Lines 8 Linear Ft: 483

Trench Width 36" Max. Trench Bottom Depth 24" Gravel Depth N/A

☑ New System ☐ Repair ☐ Expansion System Type: I II III IV V VI

System Description: GRAVITY 25% REDUCTION

Repair System Description: DEEPER BY 1983

Maintenance Agreement Required: ☐ YES ☑ NO

☑ GRAVITY ☐ PRESSURE

☑ Residence ☐ Business ☐ Other ☐ Slab ☐ Basement w/plumbing

No. Bedrooms 4 No. Persons 8 No. Employees

☑ Crawl Space

Water Supply: ☐ Private ☐ Public ☑ Community

☐ Basement w/o plumbing


Comments / Conditions: STUB PLUMBING OUT HIGH TO ACHIEVE GRAVITY FALL FROM TANK TO LINES. DUCTILE IRON SLEEVE OR EQUIVALENT REQUIRED UNDER DRIVE.

* Infiltrator Quick 4's used

INITIAL SITE SKETCH

SEE CAROLINA SOIL & SEPTIC'S PLAN

AS BUILT SKETCH

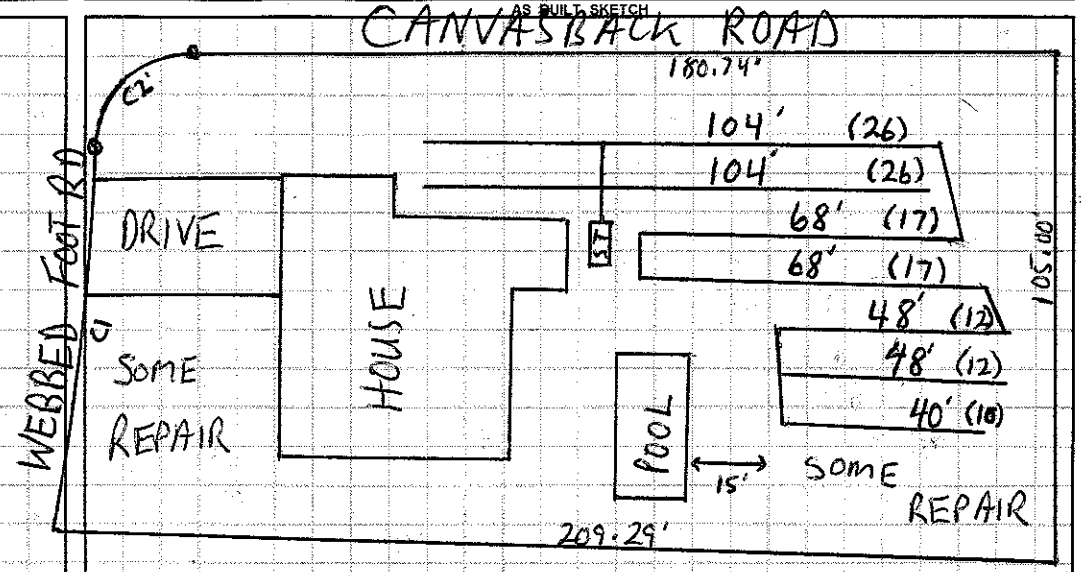

Permit can be suspended or revoked if any false information is supplied toward securing the permit / any unauthorized changes are made to the site / any unauthorized changes are made in the installation of the system. **CONTACT A LOCATOR SERVICE PRIOR TO ANY EXCAVATION**

☐ **IMPROVEMENT PERMIT** *with plat valid without expiration.* ☑ **IMPROVEMENT PERMIT** *with site plan valid for 60 mos.* ☑ **AUTHORIZATION TO CONSTRUCT** *valid for period equal to IMPROVEMENT PERMIT--not to exceed 60 mo.*

Owner / Applicant Signature: Date: 7/9/13

IMPROVEMENT PERMIT by: C. [illegible] REHS Date: 6/25/13

AUTHORIZATION TO CONSTRUCT by: Date: 8/14/13

Installed by: Frye Grading and Repair Inc

OPERATION PERMIT by: Date: 12-19-13

Existing System Inspected by: Date:

IREDELL COUNTY HEALTH DEPARTMENT

Statesville Office (704) 878-5305 Mooresville Office (704) 660-3625 PERMIT # 179429

IMPROVEMENT PERMIT / AUTHORIZATION TO CONSTRUCT / OPERATION PERMIT / EXISTING SYSTEM

PIN # 4636876794

APPLICANT: JENAPER HILL LLC APPLICANT ADDRESS: PO Box 5351 MOORESVILLE 28117

SITE ADDRESS: WEBBED FOOT DRIVE PHONE: ALT. PHONE:

SITE DIRECTIONS: BRAWLEY SCHOOL - TL CANVASBACK - CORNER OF WEBBED FOOT.

SUBDIVISION: MALLARD HEAD SECTION: LOT # 36 LOT AREA: DESIGN FLOW: 480GPD L.T.A.R.: .25

Septic Tank 1000 (gal) STB 1012 Date 10-22-13
Pump Tank (gal) PT Date
Pump Make Model Serial #
Nitrification Fields 1 # Lines 8 Linear Ft: 483
Trench Width 36" Max. Trench Bottom Depth 24" Gravel Depth N/A

☑ New System ☐ Repair ☐ Expansion System Type: I II ☑ III IV V VI
System Description: GRAVITY 25% REDUCTION
Repair System Description: DEEPED BY 1983
Maintenance Agreement Required: ☐ YES ☑ NO
☑ GRAVITY ☐ PRESSURE

☑ Residence ☐ Business ☐ Other ☐ Slab ☐ Basement w/plumbing
No. Bedrooms 4 No. Persons 8 No. Employees
☑ Crawl Space
☐ Basement w/o plumbing

Water Supply: ☐ Private ☐ Public ☑ Community


Comments / Conditions: STUB PLUMBING OUT HIGH TO ACHIEVE GRAVITY FALL FROM TANK TO LINES. DUCTILE IRON SLEEVE OR EQUIVALENT REQUIRED UNDER DRIVE.

* Infiltrator Quick 4's used

INITIAL SITE SKETCH

SEE CAROLINA SOIL & SEPTIC'S PLAN

AS BUILT SKETCH

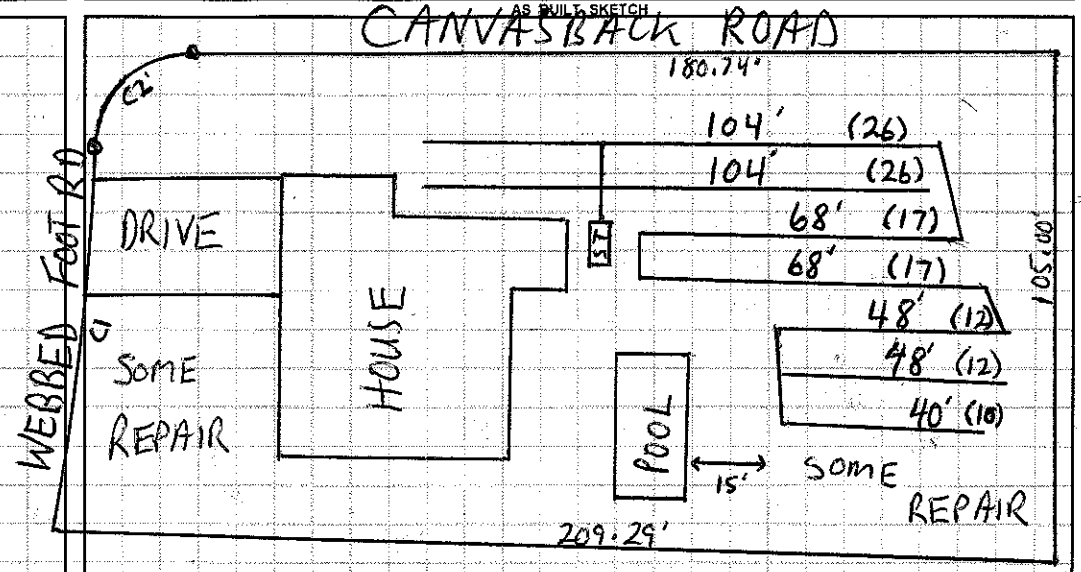

Permit can be suspended or revoked if any false information is supplied toward securing the permit / any unauthorized changes are made to the site / any unauthorized changes are made in the installation of the system. **CONTACT A LOCATOR SERVICE PRIOR TO ANY EXCAVATION**

☐ **IMPROVEMENT PERMIT** *with plat valid without expiration.* ☑ **IMPROVEMENT PERMIT** *with site plan valid for 60 mos.* ☑ **AUTHORIZATION TO CONSTRUCT** *valid for period equal to IMPROVEMENT PERMIT--not to exceed 60 mo.*

Owner / Applicant Signature: Date: 7/9/13 Installed by: Frye Grading and Repair Inc

IMPROVEMENT PERMIT by: C. Matthews REHS Date: 6/25/13 OPERATION PERMIT by: L. Pitt Date: 12-19-13

AUTHORIZATION TO CONSTRUCT by: Date: 7/14/13 Existing System Inspected by: Date: