IREDELL COUNTY HEALTH DEPARTMENT

Statesville Office (704) 878-5305 Mooresville Office (704) 660-3625 PERMIT # 179429

IMPROVEMENT PERMIT / AUTHORIZATION TO CONSTRUCT / OPERATION PERMIT / EXISTING SYSTEM

PIN # 4636876794

APPLICANT: JENAPER HILL LLC APPLICANT ADDRESS: PO BOX 5351 MOORESVILLE 28117

SITE ADDRESS: WEBBED FOOT DRIVE PHONE: ALT. PHONE:

SITE DIRECTIONS: BRAWLEY SCHOOL - TL CANVASBACK - CORNER OF WEBBED FOOT.

SUBDIVISION: MALLARD HEAD SECTION: LOT # 36 LOT AREA: DESIGN FLOW: 480 GPD L.T.A.R.: .25

Septic Tank	1000	(gal)	STB	1012	Date	10-22-13	☑ New System ☐ Repair ☐ Expansion System Type: I II (III) IV V VI	☑ Residence	No. Bedrooms	4	Water Supply
Pump Tank		(gal)	PT		Date		System Description: GRAVITY 25% REDUCTION	☐ Business	No. Persons	8	☐ Private
Pump Make			Model		Serial #		Repair System Description: DEEDED B-4 1983	☐ Other	No. Employees		☐ Public
# Nitrification Fields	1		# Lines	8	Linear Ft:	483	Maintenance Agreement Required: ☐ YES ☑ NO	☐ Slab	☑ Crawl Space		☑ Community
Trench Width	36"		Max. Trench Bottom Depth	24"	Gravel Depth	N/A	☑ GRAVITY ☐ PRESSURE	☐ Basement w/plumbing		☐ Basement w/o plumbing	


Comments / Conditions: STUB PLUMBING OUT HIGH TO ~~ACRE~~ ACHIEVE GRAVITY FALL FROM TANK TO LINES. DUCTILE IRON SLEEVE OR EQUIVALENT REQUIRED UNDER DRIVE.

* Infiltrator Quick 4's used

INITIAL SITE SKETCH

SEE CAROLINA SOIL & SEPTIC'S PLAN

AS BUILT SKETCH

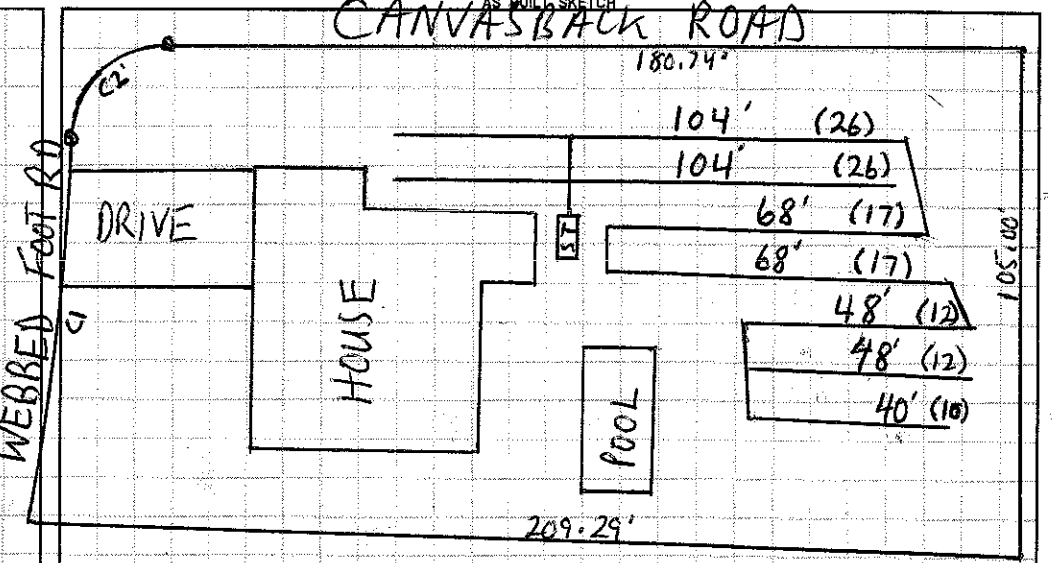

Permit can be suspended or revoked if any false information is supplied toward securing the permit / any unauthorized changes are made to the site / any unauthorized changes are made in the installation of the system. **CONTACT A LOCATOR SERVICE PRIOR TO ANY EXCAVATION**

☐ **IMPROVEMENT PERMIT** *with plat valid without expiration.* ☑ **IMPROVEMENT PERMIT** *with site plan valid for 60 mos.* ☑ **AUTHORIZATION TO CONSTRUCT** *valid for period equal to IMPROVEMENT PERMIT--not to exceed 60 mo.*

Owner / Applicant Signature: Date: 7/9/13 Installed by: Frye Grading and Repair Inc

IMPROVEMENT PERMIT by: C. Hill-Tucker HHS Date: 6/25/13 OPERATION PERMIT by: Date: 12-19-13

AUTHORIZATION TO CONSTRUCT by: C. Hill-Tucker Date: 9/14/13 Existing System Inspected by: Date:

Health Dept. Copy - WHITE Applicant (Final Approval) - YELLOW Applicant (Conditional Approval) - PINK