IREDELL COUNTY HEALTH DEPARTMENT

STATESVILLE 704-878-5305 130.00 Paid MOORESVILLE 704-664-5281

IMPROVEMENT PERMIT / AUTHORIZATION TO CONSTRUCT / OPERATION PERMIT / EXISTING SYSTEM INSPECTION

PERMIT# 123737 PIN# 4636 87 8919 DATE 9/20/04

OWNER OR CONTRACTOR Titan Custom Homes PHONE: Business 704-528-7874 Home

ADDRESS PO Box 3126 Mooresville, NC. 28117

LOCATION 1100 TL Canvasback TL 1st Woodduck Lp. Conventional (R)

SUBDIVISION Lakeside Farm BLOCK / SECTION LOT 34 LOT AREA .68 SITE CLASS. PS DESIGN FLOW 360 L.T.A.R. .3

Septic Tank: 1000 Gallons; STB 321 Date 10/5/04
Pump Tank: 1000 Gallons; PT 318 Date 9/15/04
Pump Make: Zoeller Model N-53 Serial No.
Nitrification Field: No Fields 1 Square Feet 900 * Linear Feet 300 *
No Lines 3@100 Trench Width 3' Max Trench Bottom Depth 3' Gravel Depth No

[X] New System [ ] Repair System Type: I, II, (III), IV, V, VI
System Description: Pres Man. to Type 3 *
Repair System Description: 16" PPB PS
Maintenance Agreement Required: [ ] Yes [X] No

[X] House/Mod. Home No. Bedrooms 3
[ ] Mobile Home No. Bathrooms 3
[ ] Business No. Employees
[ ] Other
[ ] Slab [X] Crawl Space [ ] Basement w/plumbing [ ] Basement wo/plumbing


Water Supply: [ ] Individual [ ] Public [X] Community

Comments:/Conditions: This is a 25% reduced system.


Comments:/Conditions:

1" = 50'

INITIAL SITE SKETCH

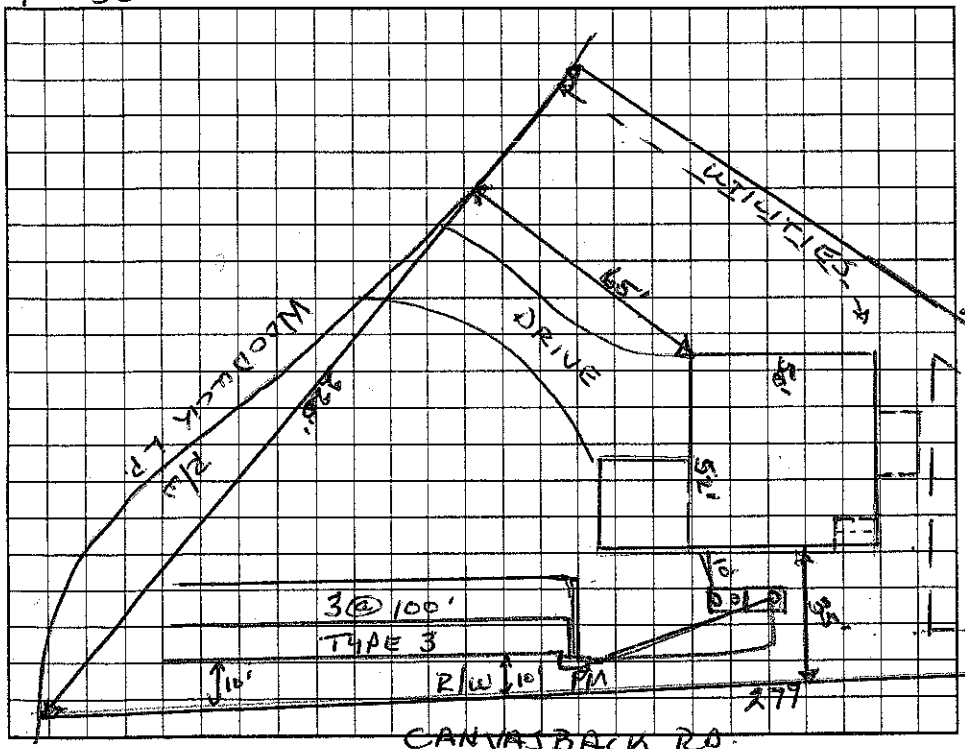

AS BUILT SKETCH

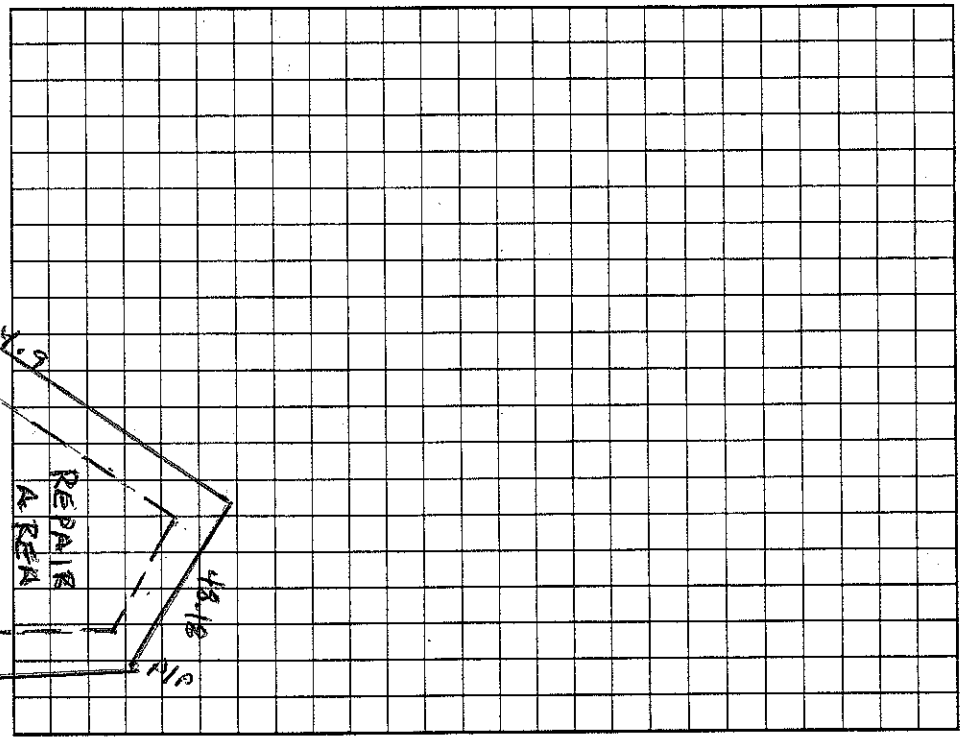

Permit can be suspended or revoked if any false information is supplied toward securing the permit/any unauthorized changes are made to the site/any unauthorized changes are made in the installation of the system. Improvement Permit with plat valid without expiration. ~~Improvement Permit with site~~ plan valid for sixty months. Authorization to Construct is valid for a period equal to that of Improvement Permit – not to exceed sixty months.

Signed: * date 10-7-04

Improvement Permit by: Wesley Sparks R.S. date 9/20/04

Authorization to Construct by: Wesley Sparks R.S. date 9/20/04

Installed by: B+M Excavating

Operation Permit by: Wesley Sparks R.S. date 2/2/05

Existing System Inspection by: date

HEALTH DEPT. COPY: WHITE OWNER COPY (FINAL): YELLOW OWNER COPY (INITIAL): PINK