IREDELL COUNTY HEALTH DEPARTMENT

Statesville Office (704) 878-5305 Mooresville Office (704) 660-3625 PERMIT # REPAIR 203202

IMPROVEMENT PERMIT / AUTHORIZATION TO CONSTRUCT / OPERATION PERMIT / EXISTING SYSTEM

PIN # 4636-87-9177

APPLICANT: BETTY MULLIS APPLICANT ADDRESS: 110 TURNBERRY LN.

SITE ADDRESS: SAME PHONE: 704-664-1239 ALT. PHONE:

SITE DIRECTIONS: CANVASBACK, TL TURNBERRY, ON R

SUBDIVISION: ST. ANDREWS VILLAGE SECTION: LOT # 33 LOT AREA: .74 AC DESIGN FLOW: 360 L.T.A.R.: .25

Septic Tank EXISTING (gal) STB Date
Pump Tank (gal) PT Date
Pump Make Model Serial #
Nitrification Fields 1 # Lines 5 Linear Ft: 360'
Trench Width 36" Max. Trench Bottom Depth 36" Gravel Depth —

☐ New System ☒ Repair ☐ Expansion System Type: I II (III) IV V VI
System Description:
Repair System Description: 25% REDUCTION
Maintenance Agreement Required: ☐ YES ☒ NO
☒ GRAVITY ☐ PRESSURE

☒ Residence No. Bedrooms 3
☐ Business No. Persons
☐ Other No. Employees
☐ Slab ☒ Crawl Space
☐ Basement w/plumbing ☐ Basement w/o plumbing


Water Supply: ☐ Private ☐ Public ☒ Community

Comments / Conditions:


15' FROM DITCH

CANVASBACK PL201

INITIAL SITE SKETCH

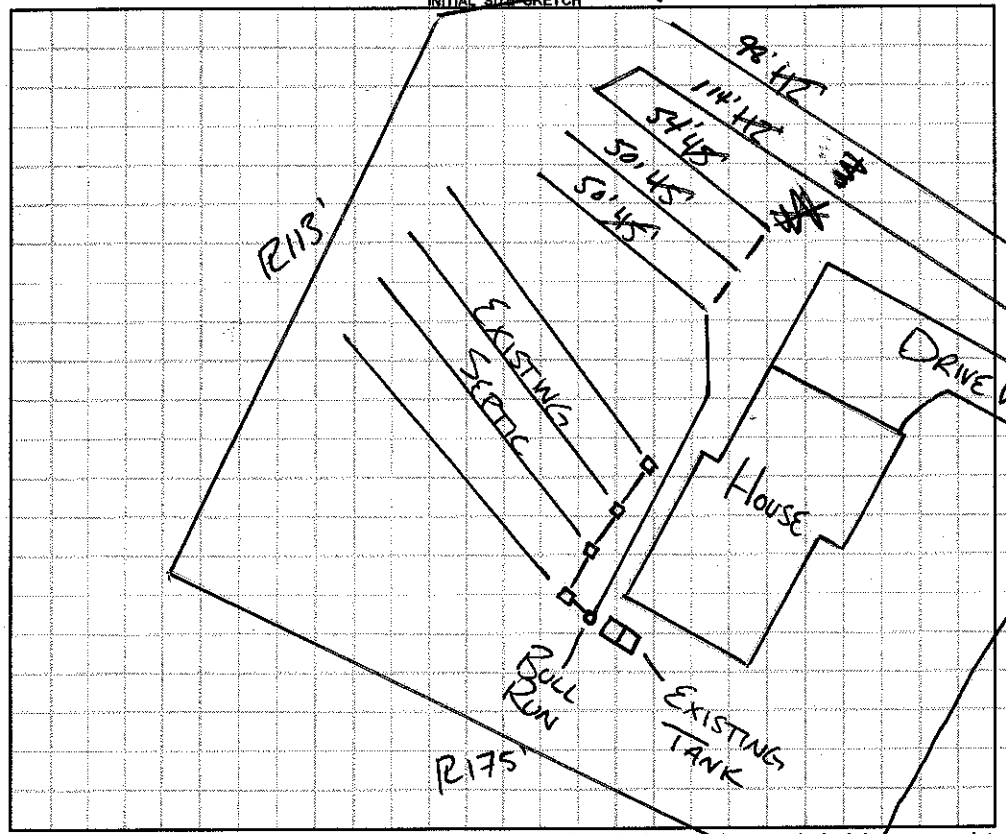

AS BUILT SKETCH

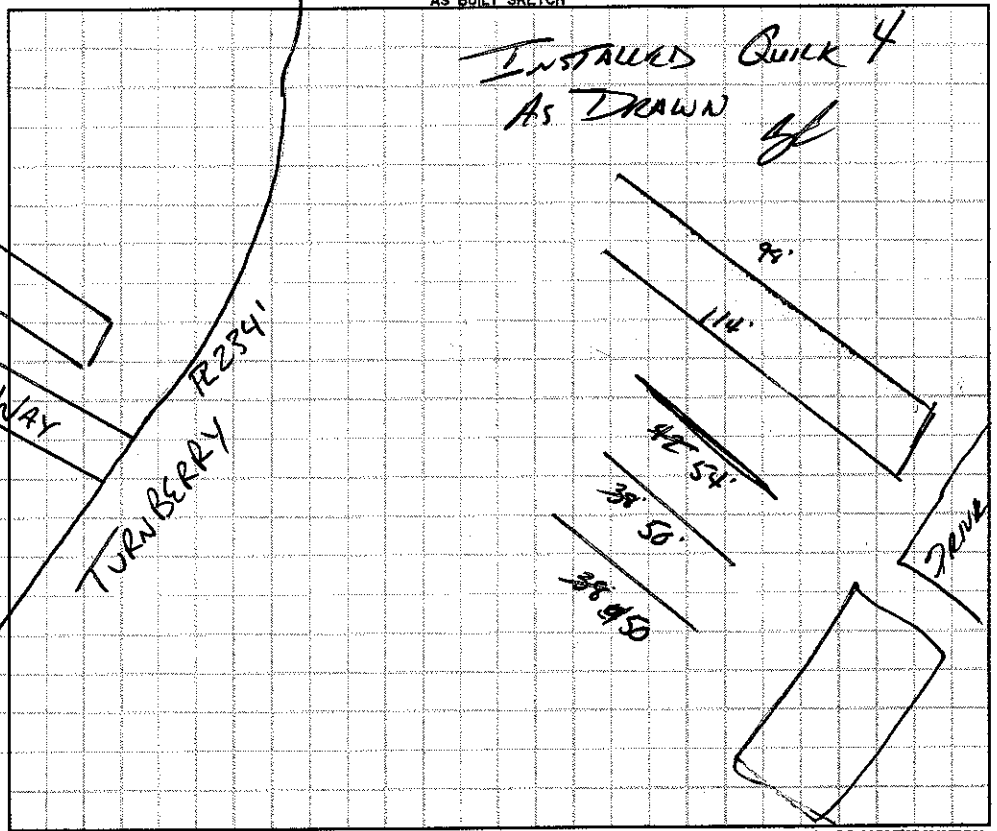

Permit can be suspended or revoked if any false information is supplied toward securing the permit / any unauthorized changes are made to the site / any unauthorized changes are made in the installation of the system. **CONTACT A LOCATOR SERVICE PRIOR TO ANY EXCAVATION**

☐ **IMPROVEMENT PERMIT** *with plat valid without expiration.* ☐ **IMPROVEMENT PERMIT** *with site plan valid for 60 mos.* ☒ **AUTHORIZATION TO CONSTRUCT** *valid for period equal to IMPROVEMENT PERMIT--not to exceed 60 mo.*

Owner / Applicant Signature: Betty Mullis Date: 5/4/15 Installed by: Al Backhoe

IMPROVEMENT PERMIT by: APPROVED MAY 01 2015 OPERATION PERMIT by: Date: 8/28/15

AUTHORIZATION TO CONSTRUCT by: APPROVED MAY 01 2015 Existing System Inspected by: Date:

Health Dept. Copy - WHITE Applicant (Final Approval) - YELLOW Applicant (Conditional Approval) - PINK