2:00

IREDELL COUNTY HEALTH DEPARTMENT

STATESVILLE 704 — MOORESVILLE 704-664-5281

IMPROVEMENT PERMIT / AUTHORIZATION TO CONSTRUCT / OPERATION PERMIT / EXISTING SYSTEM INSPECTION

PERMIT# 132400 PIN# 4636882105 DATE 8-12-08

OWNER OR APPLICANT Wesley Zdrentan PHONE: Business 658-5106 Home

ADDRESS 1016 Fantasia Ln Mooresville, NC 28117

LOCATION Brawley School Rd TL Canvasback TR Webbed Foot Rd on right across From Bufflehead

SUBDIVISION Mallard Head BLOCK / SECTION LOT 1A LOT AREA .5 Acre SITE CLASS PS DESIGN FLOW 480gpd L.T.A.R. .3

Septic Tank: 1000 Gallons: STB Date

Pump Tank: Gallons: PT Date

Pump Make: Model Serial No.

Nitrification Field: No Fields 1 Square Feet 1200 Linear Feet 400

No Lines 10 x 67 Trench Width 36" Max Trench Bottom Depth 36" Gravel Depth N/A

☒ New System ☐ Repair ☐ Expansion System Type: I II III IV V VI

System Description: Gravity - 25% Reduction

Repair System Description: ~~X~~ Rapid Block

Maintenance Agreement Required: ☐ Yes ☐ No

☒ House/Mod. Home ☐ Mobile Home ☐ Business ☐ Other

No. Bedrooms 4 No. Persons No. Employees


Water Supply: ☒ Individual ☐ Public ☐ Community

☒ Gravity ☐ Pressure ☐ Slab ☒ Crawl Space ☐ Basement w/plumbing ☐ Basement wo/plumbing


Comments/Conditions: Must keep Septic System At least 50ft From any well.

Comments/Conditions: ~~X~~ Lot deeded prior to 1983, "Repair Area" not required, but must save whatever room is left for Partial repair.
2-16pcs 4-17 panels

INITIAL SITE SKETCH Scale 1:50'

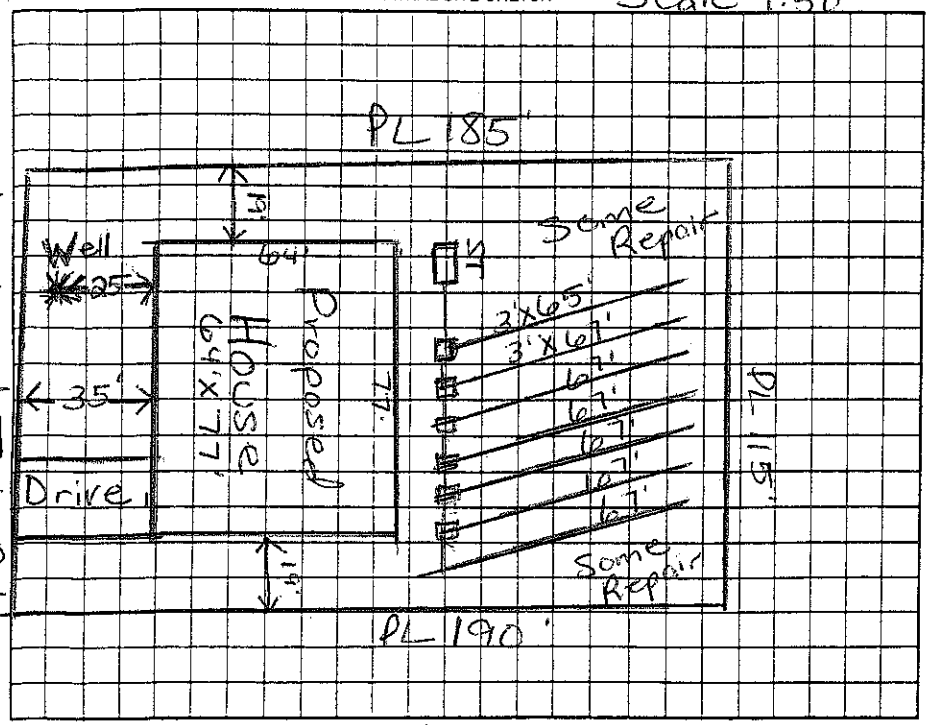

AS BUILT SKETCH

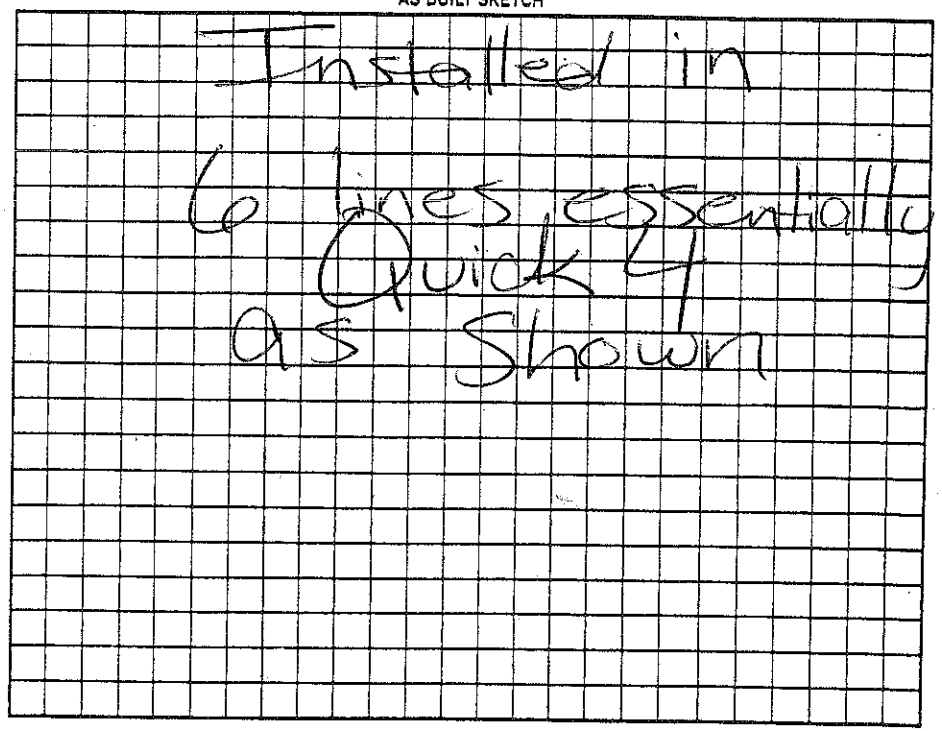

Permit can be suspended or revoked if any false information is supplied toward securing the permit/any unauthorized changes are made to the site/any unauthorized changes are made in the installation of the system. Improvement Permit with plat valid without expiration ☐ Improvement Permit with site plan valid for sixty months ☐ Authorization to Construct is valid for a period equal to that of Improvement Permit – not to exceed sixty months.

Signed: date 8-12-08

Improvement Permit by: Maria H. Dotson RS date 8/12/08

Authorization to Construct by: Maria H. Dotson RS date 8/12/08

Installed by: Rowan Septic

Operation Permit by: Maria H. Dotson RS date 12/5/08

Existing System Inspection by: date

HEALTH DEPT. COPY: WHITE OWNER COPY (FINAL): YELLOW OWNER COPY (INITIAL): PINK