IREDELL COUNTY HEALTH DEPARTMENT

Authorization To Construct

STATESVILLE 704-878-5305 MOORESVILLE 704-664-5281

IMPROVEMENT PERMIT / ~~CERTIFICATE OF COMPLETION~~ / OPERATION PERMIT / EXISTING SYSTEM INSPECTION

PROPERTY DESCRIPTION NO. 21737 DATE 10/3/95 TAX MAP NO. 2K 10 B3 Watershed: X Yes ☐ No

OWNER OR CONTRACTOR Mike Sweat ~~PHONE: Business~~ 4636-88-3366 Home 896-5732

ADDRESS 244 Freeway Dr. Mooresville, NC. 28115

LOCATION Concrete Rd. on (R) past Quinn Ln. with large red barn

SUBDIVISION JOSH ACRES BLOCK / SECTION ____ LOT 3 LOT AREA ~1.5AC SITE CLASS PS DESIGN FLOW 360 L.T.A.R. .325

Septic Tank: 1000 Gallons; STB 794 Date 12/12/95

Pump Tank: ____ Gallons; PT ____ Date ____

Pump Make: ____ Model ____ Serial No. ____

Nitrification Field: No Fields 1 Square Feet 1107 Linear Feet 369*

No Lines 2 Trench Width 36" Max Trench Bottom Depth 32" Gravel Depth N/A

X New System ☐ Repair System Type: I, II, (III), IV, V, VI

System Description: GRAV. INFILTRATOR

Repair System Description: ____

Maintenance Agreement Required: ☐ Yes ☐ No

X House/Mod. Home No. Bedrooms 3

☐ Mobile Home No. Bathrooms 3

☐ Business No. Employees ____

☐ Other ____


☐ Slab X Crawl Space ☐ Basement w/plumbing ☐ Basement wo/plumbing

Water Supply: ☐ Individual X Community ☐ Public FEDERMONT


Comments: TIGHT - HOUSE LOCATION CRITICAL
*25% reduction for chamber use.

Comments: Installed as Authorized by Permit.

INITIAL SITE SKETCH

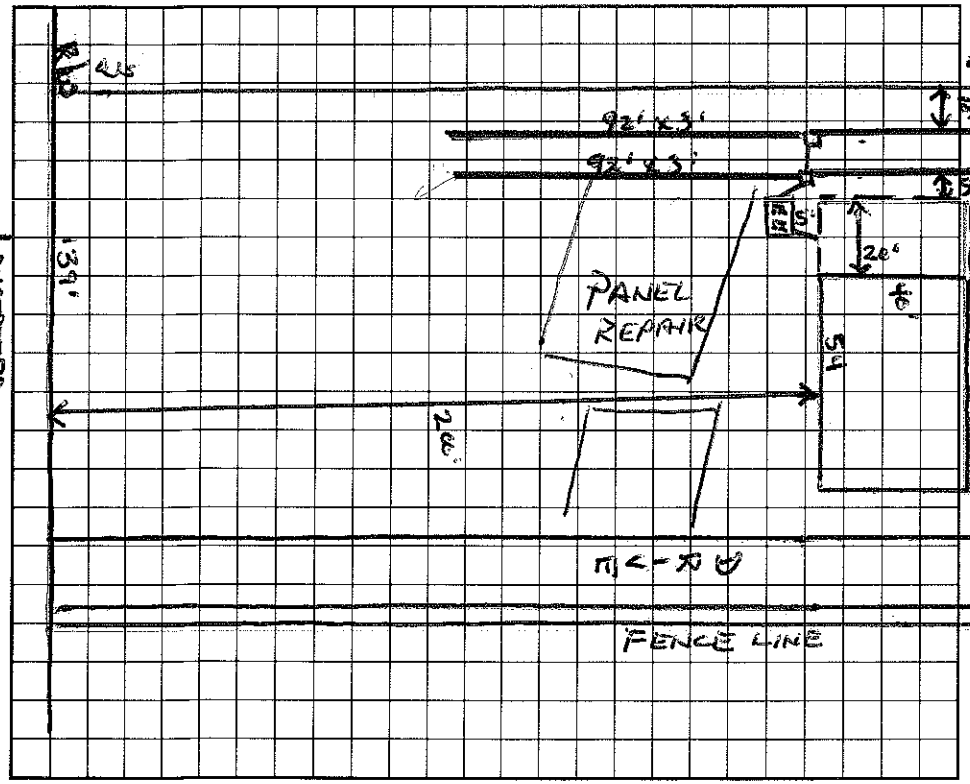

AS BUILT SKETCH

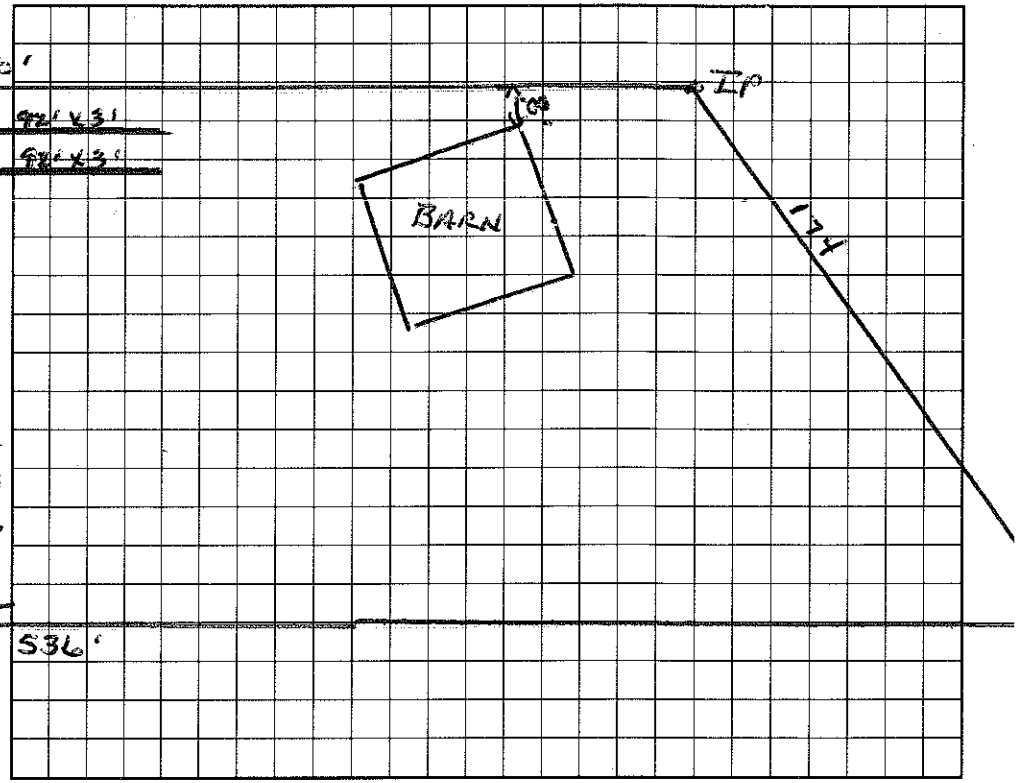

I understand that this permit can be suspended or revoked if any false information is supplied toward securing the permit/any unauthorized changes are made to the site/any unauthorized changes are made in the installation of the system.

AUTHORIZATION TO CONSTRUCT VALID 5 YRS. FROM ISSUE DATE.

Signed: X Mike J. Sweat

Improvement Permit by: Wesley Sparks R.S. date 10/3/95

~~Authorization to Construct~~ by: Wesley Sparks R.S. date 10/3/95

Installed by: Ray Beam

~~Certificate of Completion~~ by: ____ date ____

Operation Permit by: Wesley Sparks R.S. date 3/5/96

HEALTH DEPT. COPY: WHITE INSPECTION COPY (FINAL): GREEN OWNER COPY (FINAL): YELLOW INSPECTION COPY (INITIAL): PINK OWNER COPY (INITIAL): GOLD