3.00- B's

IREDELL COUNTY HEALTH DEPARTMENT

STATESVILLE 704-878-5305 MOORESVILLE 704-664-5281

IMPROVEMENT PERMIT / AUTHORIZATION TO CONSTRUCT / OPERATION PERMIT / EXISTING SYSTEM INSPECTION

PERMIT# 109355 PIN# 4636884755 3746 DATE 11-6-2002

OWNER OR CONTRACTOR Dean Davis PHONE: Business _____ Home (704) 575-5304

ADDRESS 3601-M Dry brook Rd Charlotte NC 28269

LOCATION Brawley School Rd TL Canvasback TR Fantasy Ln on left

SUBDIVISION Josh Acres BLOCK / SECTION _____ LOT 5&6 LOT AREA 1.79 Acres SITE CLASS. PS DESIGN FLOW 600gpd L.T.A.R. .3-.25

Septic Tank: 1000 Gallons: STB 825 Date 1/1/05

Pump Tank: _____ Gallons: PT _____ Date _____

Pump Make: _____ Model _____ Serial No. _____

Nitrification Field: No Fields 1 Square Feet 1998 Linear Feet 666'

No Lines 6@111 Trench Width 36" Max Trench Bottom Depth 36" Gravel Depth 12"

☒ New System ☐ Repair System Type: I II III IV V VI

System Description: Gravity-Conventional

Repair System Description: Gravity-Innovative

Maintenance Agreement Required: ☐ Yes ☒ No

☒ House/Mod. Home ☐ Mobile Home ☐ Business ☐ Other

No. Bedrooms 4 No. Bathrooms 4 No. Employees _____


☐ Slab ☒ Crawl Space ☐ Basement w/plumbing ☐ Basement wo/plumbing

Water Supply: ☒ Individual ☐ Public ☐ Community


Comments/Conditions: Fantasy Ln

Comments/Conditions: Lots 5&6 will be combined; need new plat prior to A.C. Approval. Keep Septic System 10' From DL & 15' From pool.

INITIAL SITE SKETCH

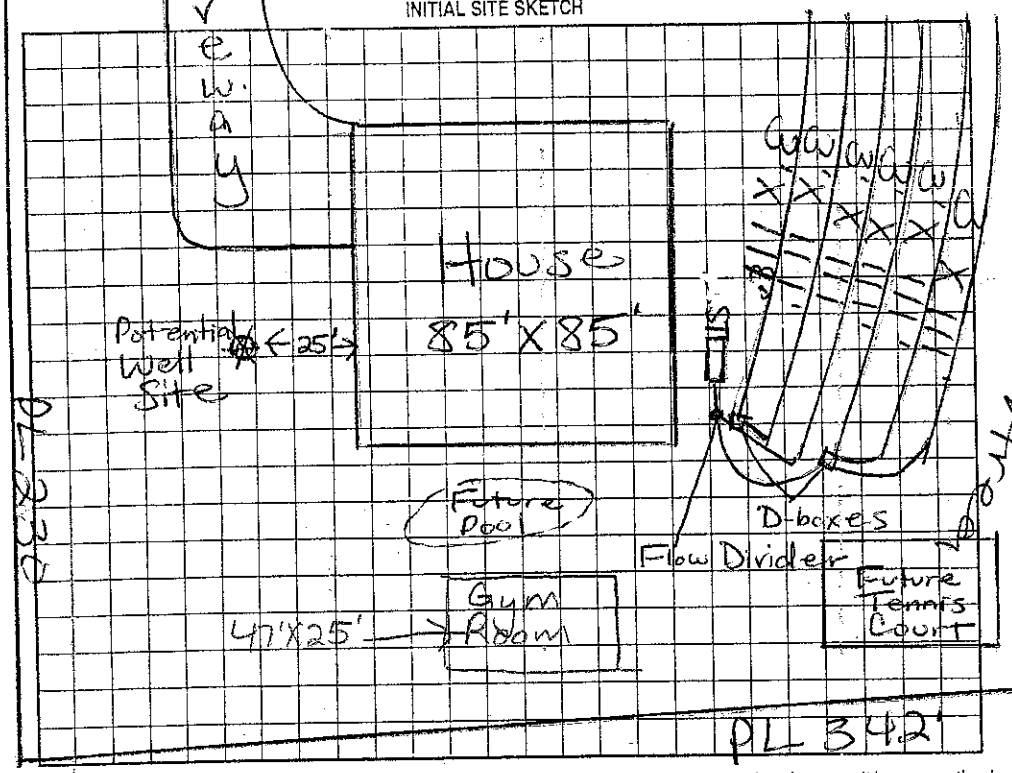

AS BUILT SKETCH

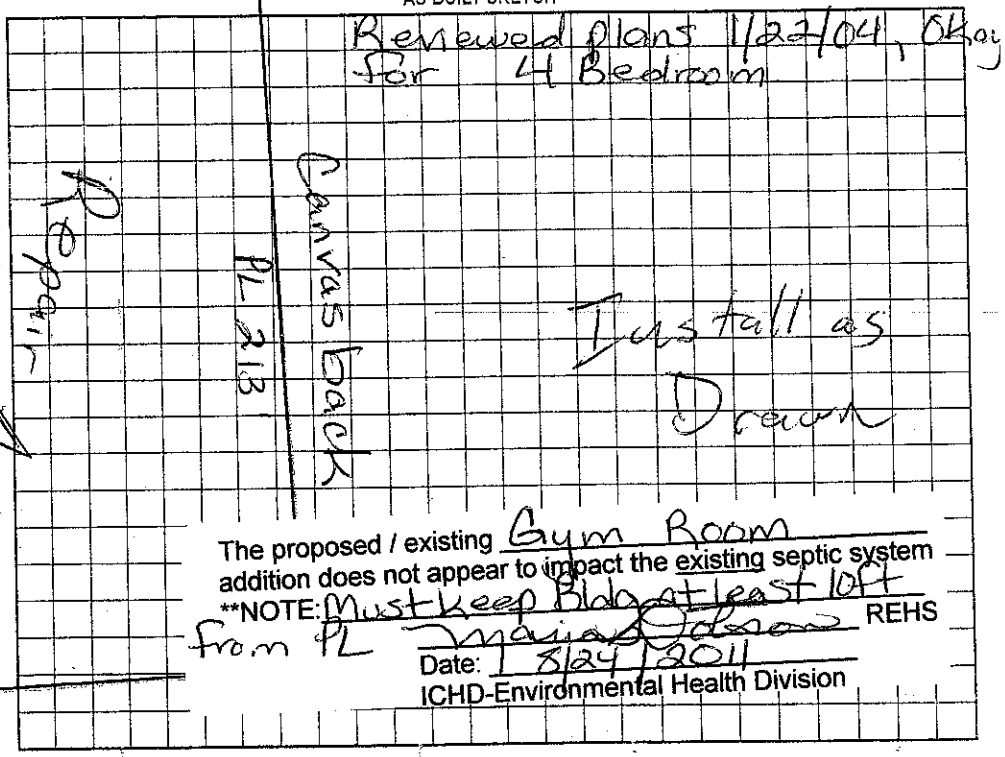

Renewed plans 1/22/04, Okay for 4 Bedroom

The proposed / existing Gym Room addition does not appear to impact the existing septic system

**NOTE: Must keep Bldg at least 10ft from PL

REHS

Date: 8/24/2011

ICHD-Environmental Health Division

Permit can be suspended or revoked if any false information is supplied toward securing the permit/any unauthorized changes are made to the site/any unauthorized changes are made in the installation of the system. Improvement Permit with plat valid without expiration. Improvement Permit with site plan valid for sixty months. Authorization to Construct is valid for a period equal to that of Improvement Permit – not to exceed sixty months.

Signed: Dean Davis date 11-08-02 Installed by: Rowan Septic

Improvement Permit by: Maria H Johnson RS date 11/7/2002 Operation Permit by: [signature] RS date 3/7/05

Authorization to Construct by: Maria H Johnson RS date 1/22/04 Existing System Inspection by: _____ date _____

HEALTH DEPT. COPY: WHITE OWNER COPY (FINAL): YELLOW OWNER COPY (INITIAL): PINK

3:00-

IREDELL COUNTY HEALTH DEPARTMENT

STATESVILLE 704-878-5305 MOORESVILLE 704-664-5281

IMPROVEMENT PERMIT / AUTHORIZATION TO CONSTRUCT / OPERATION PERMIT / EXISTING SYSTEM INSPECTION

PERMIT# 109355 PIN# 4636884755 3746 DATE 11-6-2002

OWNER OR CONTRACTOR Dean Davis PHONE: Business _____ Home (704) 575-5304

ADDRESS 3601-M Dry brook Rd Charlotte NC 28269

LOCATION Brawley School Rd TL Canvasback TR Fantasy Ln on left

SUBDIVISION Josh Acres BLOCK / SECTION _____ LOT 5&6 LOT AREA 1.79 Acres SITE CLASS PS DESIGN FLOW 600gpd L.T.A.R. .3-.25

Septic Tank: 1000 Gallons; STB 625 Date 1/1/05
Pump Tank: _____ Gallons; PT _____ Date _____
Pump Make: _____ Model _____ Serial No. _____
Nitrification Field: No Fields 1 Square Feet 1998 Linear Feet 666'
No Lines 6@111 Trench Width 36" Max Trench Bottom Depth 36" Gravel Depth 12"

☒ New System ☐ Repair System Type: I, II, III, IV, V, VI
System Description: Gravity-Conventional
Repair System Description: Gravity-Innovative
Maintenance Agreement Required: ☐ Yes ☒ No


☒ House/Mod. Home ☐ Mobile Home ☐ Business ☐ Other
No. Bedrooms 4 No. Bathrooms 4 No. Employees _____
☐ Slab ☒ Crawl Space ☐ Basement w/plumbing ☐ Basement wo/plumbing

Water Supply: ☒ Individual ☐ Public ☐ Community


Comments/Conditions: Fantasy Ln

Comments/Conditions: Lots 5&6 will be combined, need new plat prior to A.C. Approval. Keep Septic System 10' from PL & 15' from pool.

INITIAL SITE SKETCH

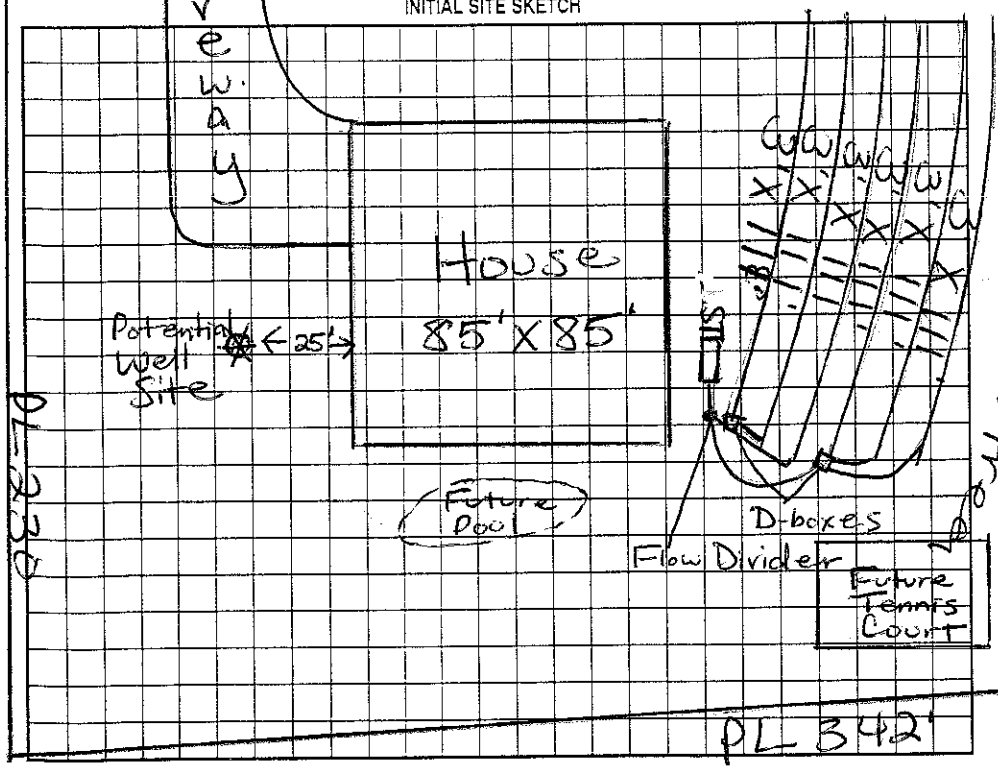

AS BUILT SKETCH

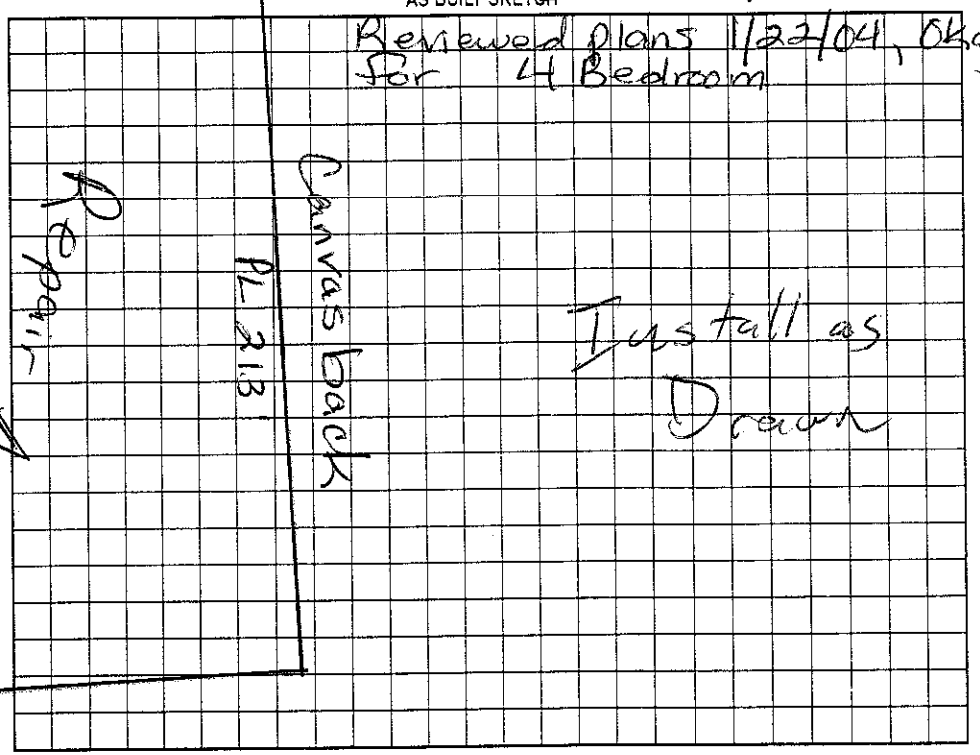

Permit can be suspended or revoked if any false information is supplied toward securing the permit/any unauthorized changes are made to the site/any unauthorized changes are made in the installation of the system. Improvement Permit with plat valid without expiration. Improvement Permit with site plan valid for sixty months. Authorization to Construct is valid for a period equal to that of Improvement Permit – not to exceed sixty months.

Signed: Dean Davis date 11-08-02 Installed by: Rowan Septic

Improvement Permit by: Maria H. Tolson RS date 11/7/2002 Operation Permit by: [signature] RS date 3/7/05

Authorization to Construct by: Maria H. Tolson RS date 11/22/04 Existing System Inspection by: _____ date _____

HEALTH DEPT. COPY: WHITE OWNER COPY (FINAL): YELLOW OWNER COPY (INITIAL): PINK