IREDELL COUNTY HEALTH DEPARTMENT

ESVILLE 704-878-5305 130.00 Paid MOORESVILLE 704-664-5281

IMPROVEMENT PERMIT / AUTHORIZATION TO CONSTRUCT / OPERATION PERMIT / EXISTING SYSTEM INSPECTION

PERMIT# 129122 PIN# 4636 88 7577 DATE 7-28-05

OWNER OR CONTRACTOR EFC Assoc. PHONE: Business 704-664-8047 Home 704-239-2022

ADDRESS 101 Gastles Gate Dr. Mooresville 28117

LOCATION Brawley Schl. Rd., TL Canvasback, on left about ½ mi, (159 Canvasback)

SUBDIVISION Regency Lake Village BLOCK / SECTION F LOT 9 LOT AREA .589 Ac SITE CLASS. PS DESIGN FLOW 480 L.T.A.R. .275

Septic Tank: 1000 Gallons; STB 1007 Date 12-7-05
Pump Tank: _____ Gallons; PT _____ Date _____
Pump Make: _____ Model _____ Serial No. _____
Nitrification Field: No Fields 1 Square Feet 1745 Linear Feet 291
No Lines 10@50' Trench Width 36" Max Trench Bottom Depth 36" Gravel Depth NA

☒ New System ☐ Repair System Type: I, II, (III) IV, V, VI
System Description: PPBPS, gravity
Repair System Description: PPBPS, gravity pm
Maintenance Agreement Required: ☐ Yes ☒ No


☒ House/Mod. Home No. Bedrooms 4
☐ Mobile Home No. Bathrooms ____
☐ Business No. Employees ____
☐ Other ____
☐ Slab ☒ Crawl Space ☐ Basement w/plumbing ☐ Basement wo/plumbing

Water Supply:
☐ Individual
☐ Public
☒ Community

Comments:/Conditions:

Comments:/Conditions:
Gray Label Filter
ST w/ marker

INITIAL SITE SKETCH

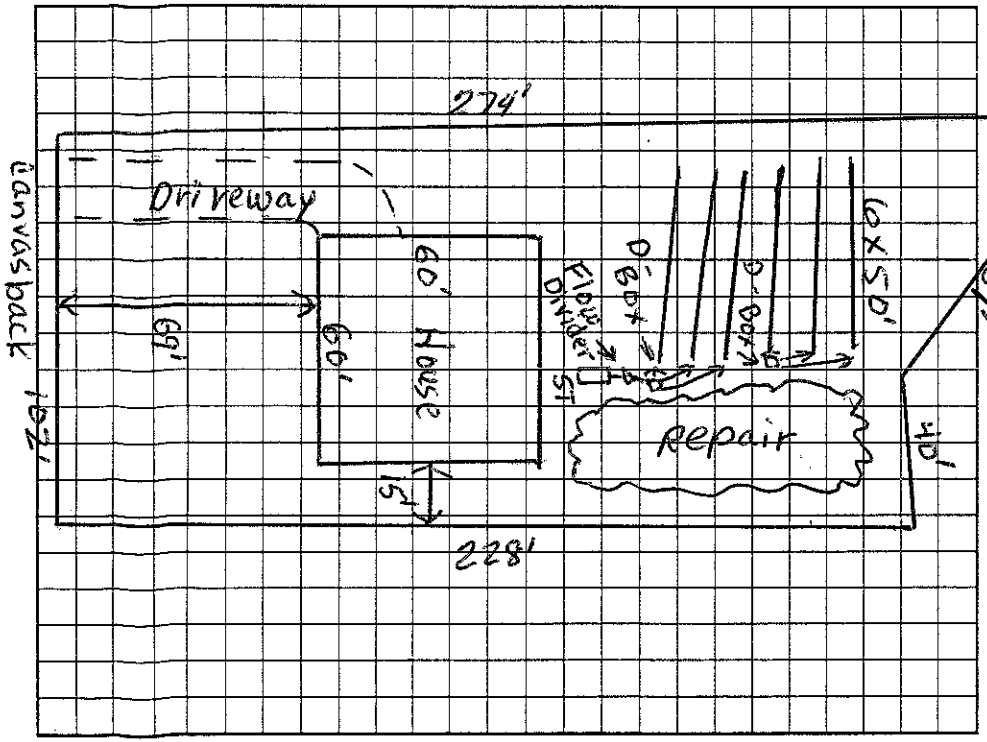

AS BUILT SKETCH

Panel Block w/ Flow Divider & D-Boxes Installed as per initial site sketch

Permit can be suspended or revoked if any false information is supplied toward securing the permit/any unauthorized changes are made to the site/any unauthorized changes are made in the installation of the system. Improvement Permit with plat valid without expiration. Improvement Permit with site plan valid for sixty months. Authorization to Construct is valid for a period equal to that of Improvement Permit – not to exceed sixty months.

Signed: [signature] date 7-29-05 Installed by: Richard A Abernathy

Improvement Permit by: Judy Melville date 7-28-05 Operation Permit by: Judy Melville date 2-7-06

Authorization to Construct by: Judy Melville date 7-28-05 Existing System Inspection by: _____ date _____

HEALTH DEPT. COPY: WHITE OWNER COPY (FINAL): YELLOW OWNER COPY (INITIAL): PINK