IREDELL COUNTY HEALTH DEPARTMENT

STATESVILLE 704-878-5305 - O - MOORESVILLE 704-664-5281

IMPROVEMENT PERMIT / AUTHORIZATION TO CONSTRUCT / OPERATION PERMIT / EXISTING SYSTEM INSPECTION

PERMIT# 090199 PIN# ~~4636 88 7659~~ Pt. 4636-88-7667 DATE 7/5/00

OWNER OR CONTRACTOR Roger D. Mc Guffey PHONE: Business 664-2678 Home

ADDRESS 196 Hazelton Lp. Mooresville, NC. 28117

LOCATION 155 Conversback Rd, 1100 TL Conversback to ~ 4th lot on (L)

SUBDIVISION Regency Lake BLOCK / SECTION F LOT 6 LOT AREA .64 AC SITE CLASS PS DESIGN FLOW 360 L.T.A.R. .3

Septic Tank: 1000 Gallons; STB 794 Date 1/24/00
Pump Tank: Gallons; PT Date
Pump Make: Model Serial No.
Nitrification Field: No Fields 1 Square Feet 9200 Linear Feet 400
No Lines 5a 80'x3' Trench Width 36" Max Trench Bottom Depth 36" Gravel Depth 12"

[X] New System [ ] Repair, System Type: I, (II), III, IV, V, VI
System Description: Gravity - Conventional
Repair System Description: 16" PPBS
Maintenance Agreement Required: [ ] Yes [ ] No

[X] House/Mod. Home No. Bedrooms 3
[ ] Mobile Home No. Bathrooms 3
[ ] Business No. Employees
[ ] Other
[ ] Slab [X] Crawl Space [ ] Basement w/plumbing [ ] Basement wo/plumbing


Water Supply:
[ ] Individual
[ ] Public
[X] Community

Comments:/Conditions:


Comments:/Conditions:

(1" = 30')

INITIAL SITE SKETCH

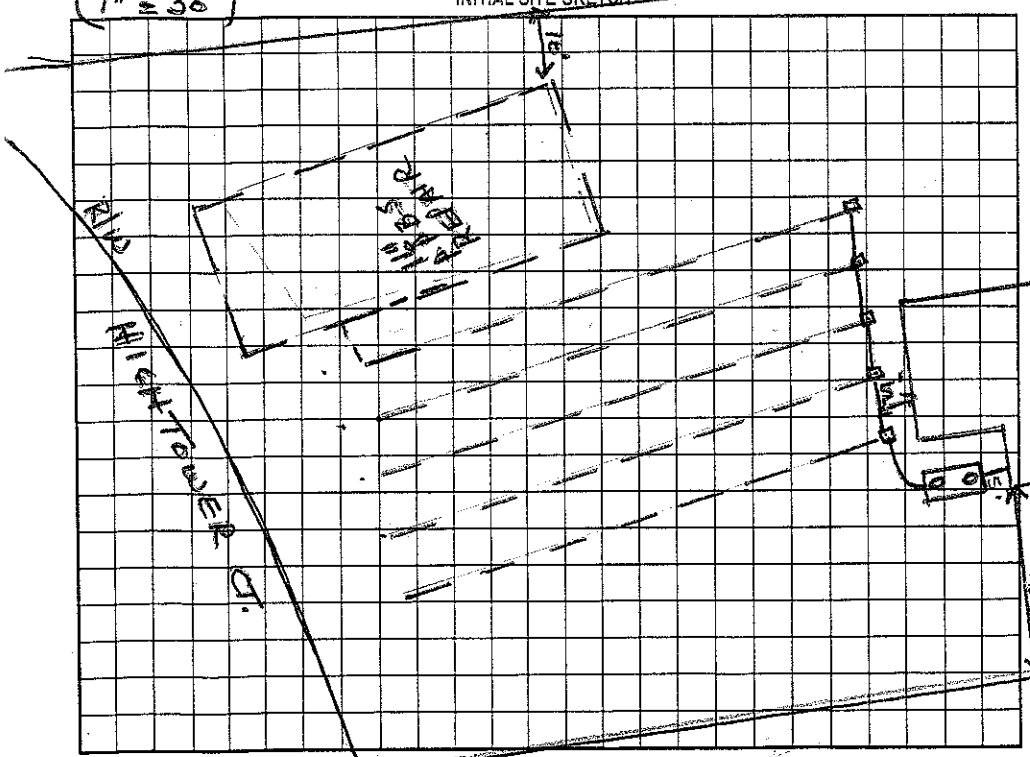

AS BUILT SKETCH

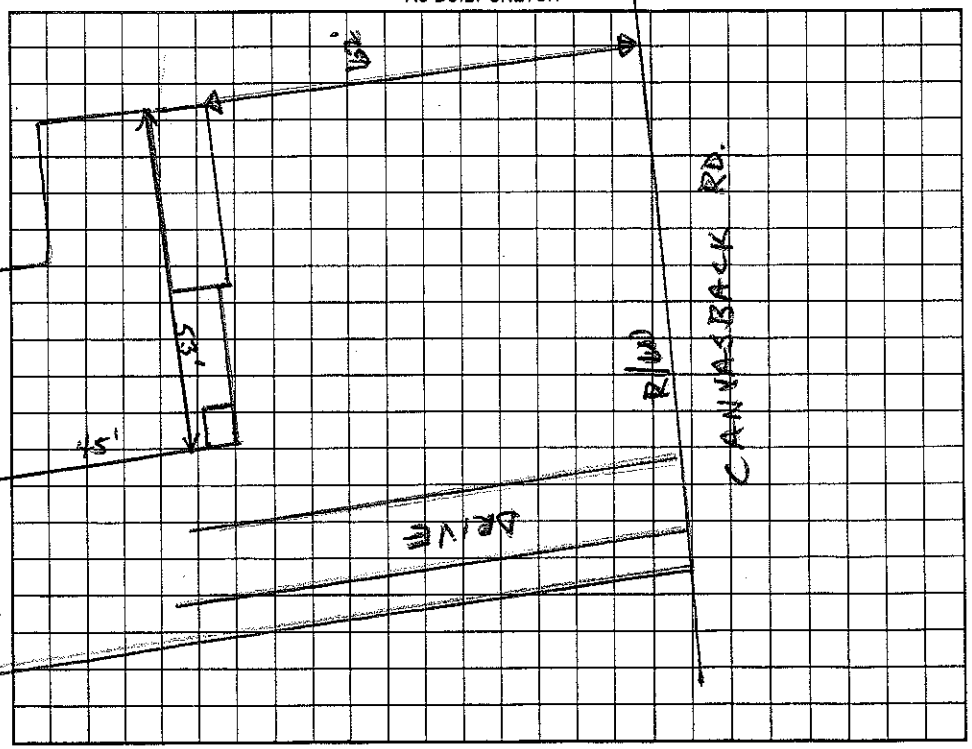

Permit can be suspended or revoked if any false information is supplied toward securing the permit/any unauthorized changes are made to the site/any unauthorized changes are made in the installation of the system. Improvement Permit with plat valid without expiration. Improvement Permit with site plan valid for sixty months. Authorization to Construct is valid for a period equal to that of Improvement Permit – not to exceed sixty months.

Signed: x Kelli C. McGuffey date 8/17/00 Installed by: Buddy Chaney

Improvement Permit by: Wesley Sparks RS. date 7/5/00 Operation Permit by: Wesley Sparks RS date 11/16/00

Authorization to Construct by: Wesley Sparks RS. date 7/5/00 Existing System Inspection by: date

HEALTH DEPT. COPY: WHITE OWNER COPY (FINAL): YELLOW OWNER COPY (INITIAL): PINK