# IREDELL COUNTY HEALTH DEPARTMENT

STATESVILLE 704-878-5305 - MOORESVILLE 704-664-5281

## IMPROVEMENT PERMIT / AUTHORIZATION TO CONSTRUCT / OPERATION PERMIT / EXISTING SYSTEM INSPECTION

PERMIT# 090199 PIN# 4636 88 7657 pt. DATE 7/5/00

OWNER OR CONTRACTOR Roger D. McGuffey PHONE: ~~Business~~ 664-2678 Home

ADDRESS 196 Hayelton Lp. Mooresville, NC. 28117

LOCATION 155 Canvasback Rd, 1100 TL Canvasback to ~ 4th lot on (L)

SUBDIVISION Regency Lake BLOCK / SECTION LOT 6 LOT AREA .6 AC SITE CLASS. PS DESIGN FLOW 360 L.T.A.R. .3

Septic Tank: 1000 Gallons; STB 794 Date 1/21/00
Pump Tank: Gallons; PT Date
Pump Make: Model Serial No.
Nitrification Field: No Fields 1 Square Feet 1200 Linear Feet 400
No Lines 5 @ 80' x 3' Trench Width 36" Max Trench Bottom Depth 36" Gravel Depth 12"

☒ New System ☐ Repair . System Type: I, (II), III, IV, V, VI
System Description: Gravity - Conventional
Repair System Description: 16" PPBS
Maintenance Agreement Required: ☐ Yes ☐ No

☒ House/Mod. Home ☐ Mobile Home ☐ Business ☐ Other
No. Bedrooms 3 No. Bathrooms 3 No. Employees

☐ Slab ☒ Crawl Space ☐ Basement w/plumbing ☐ Basement wo/plumbing


Water Supply: ☐ Individual ☐ Public ☒ Community

Comments:/Conditions:


Comments:/Conditions:

(1" = 30')

INITIAL SITE SKETCH

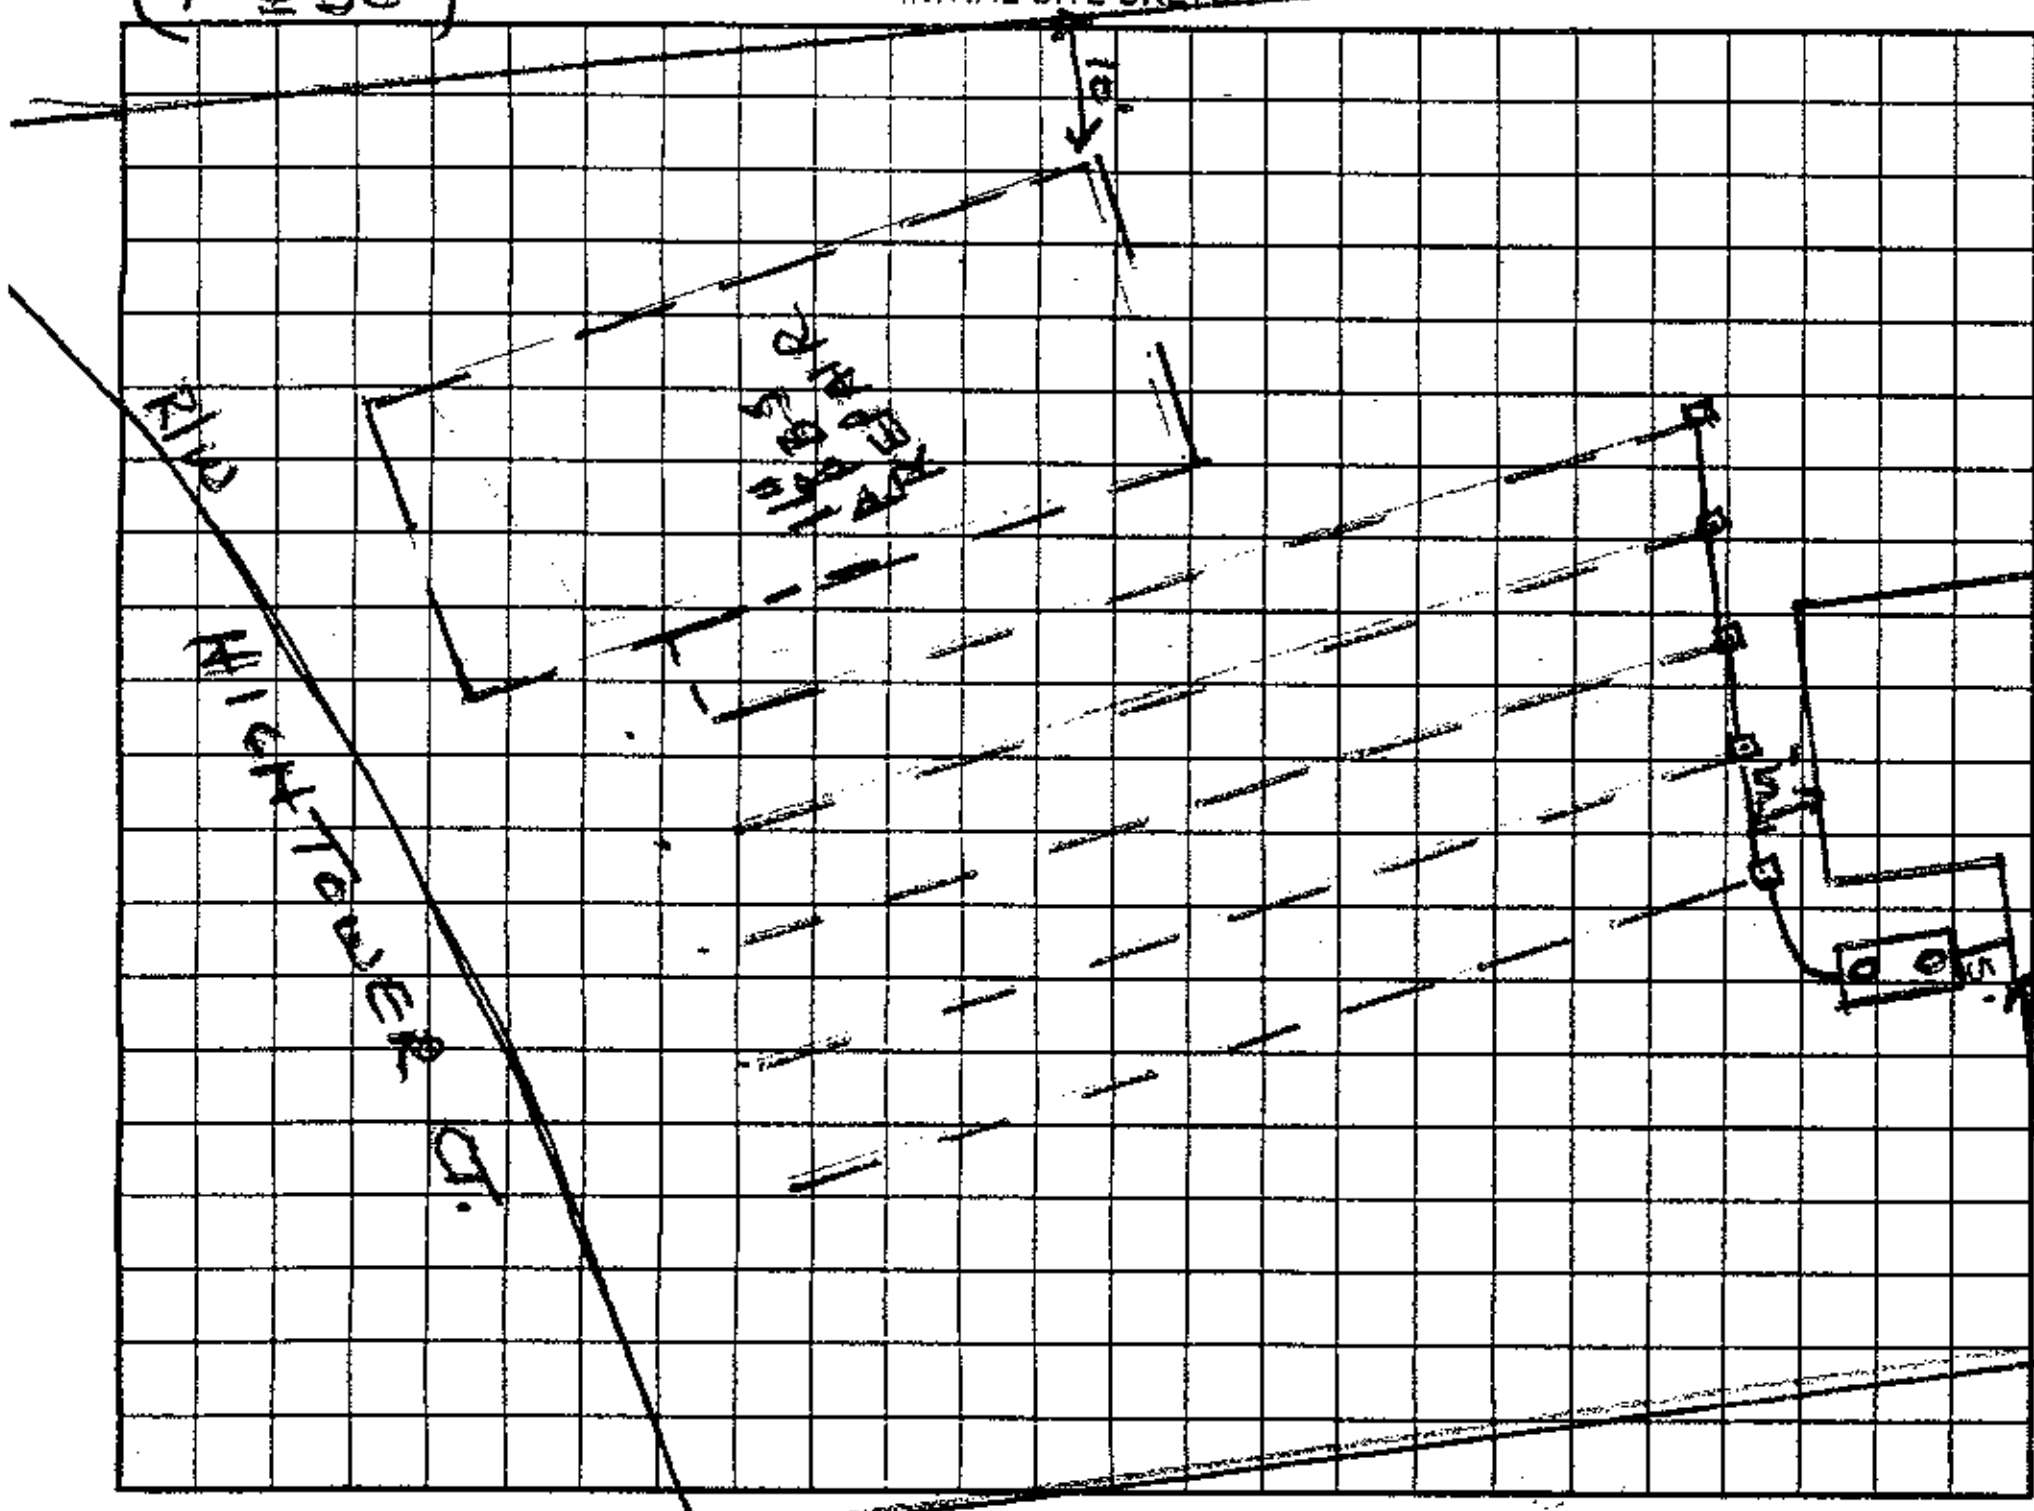

AS BUILT SKETCH

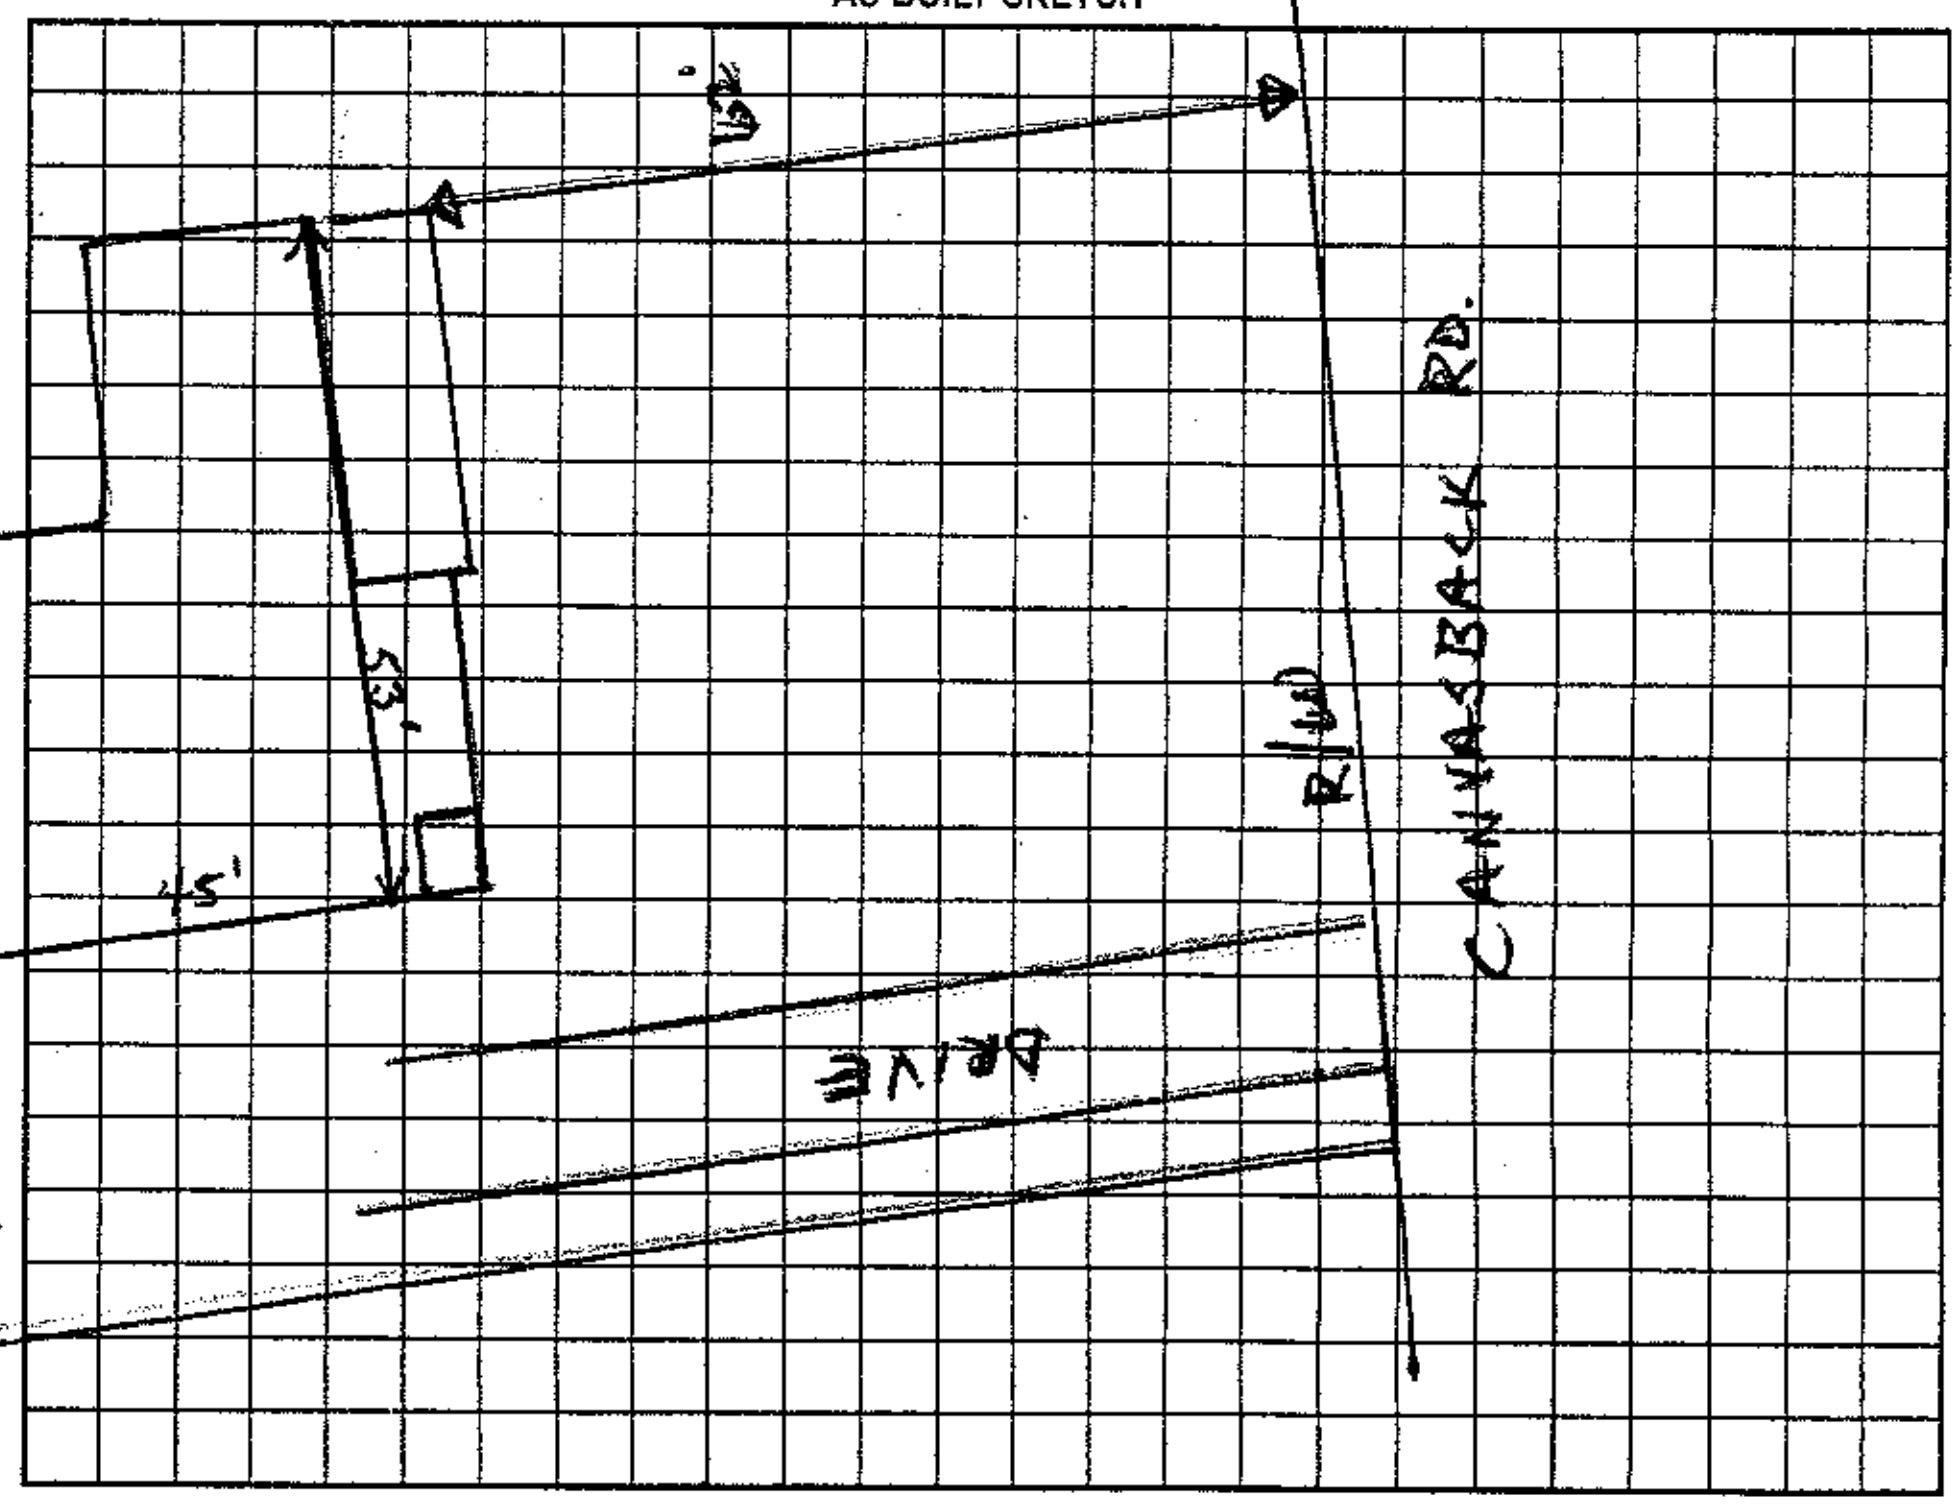

Permit can be suspended or revoked if any false information is supplied toward securing the permit/any unauthorized changes are made to the site/any unauthorized changes are made in the installation of the system. Improvement Permit with plat valid without expiration. Improvement Permit with site plan valid for sixty months. Authorization to Construct is valid for a period equal to that of Improvement Permit – not to exceed sixty months.

Signed: x Kellie C McGuffey date 8/17/00 Installed by: Buddy Chaney

Improvement Permit by: Wesley Sparks RS. date 7/5/00 Operation Permit by: Wesley Sparks RS date 11/16/00

Authorization to Construct by: Wesley Sparks RS. date 7/5/00 Existing System Inspection by: date

HEALTH DEPT. COPY: WHITE OWNER COPY (FINAL): YELLOW OWNER COPY (INITIAL): PINK