IREDELL COUNTY HEALTH DEPARTMENT

4636-88-7809

STATESVILLE 704-878-5305 MOORESVILLE 704-664-5281

IMPROVEMENT PERMIT / CERTIFICATE OF COMPLETION / OPERATION PERMIT / EXISTING SYSTEM INSPECTION

PROPERTY DESCRIPTION NO. 17880 DATE March 7, '94 TAX MAP NO. 2K 7E3 Watershed: ☑ Yes ☐ No

OWNER OR CONTRACTOR Newman McDade PHONE: Business 892-7991 Home L.N.

ADDRESS P.O. Box 131, Mt. Mourne → mobile 576-3220

LOCATION 1190 TL 1179 on left 3rd lot past jct w/ Regency Rd.

SUBDIVISION Regency Lake BLOCK / SECTION F LOT 3 LOT AREA 75 x n 225' SITE CLASS. RS DESIGN FLOW 360 gpd L.T.A.R. .3

Septic Tank: 1000 Gallons; STB 825 RST Date 5-1-94

Pump Tank: _____ Gallons; PT _____ Date _____

Pump Make: _____ Model _____ Serial No. _____

Nitrification Field: No Fields 2 Square Feet 1200 Linear Feet 408

No Lines 4+4 Trench Width 36" Max Trench Bottom Depth 36" Gravel Depth _____

☑ New System ☐ Repair System Type: I, II, III, IV, V, VI

System Description: gravity Conventional

Repair System Description: Same

Maintenance Agreement Required: ☐ Yes ☐ No

☑ House/Mod. Home No. Bedrooms 3

☐ Mobile Home No. Bathrooms 2

☐ Business No. Employees _____

☐ Other _____


☐ Slab ☑ Crawl Space ☐ Basement w/plumbing ☐ Basement wo/plumbing

Water Supply: ☐ Individual ☑ Community ☐ Public


Comments: Lot recorded in July, 1970. Can maintain only 5' off left side boundary w/ septic system. Additional repair area in front yard.

Comments:

INITIAL SITE SKETCH

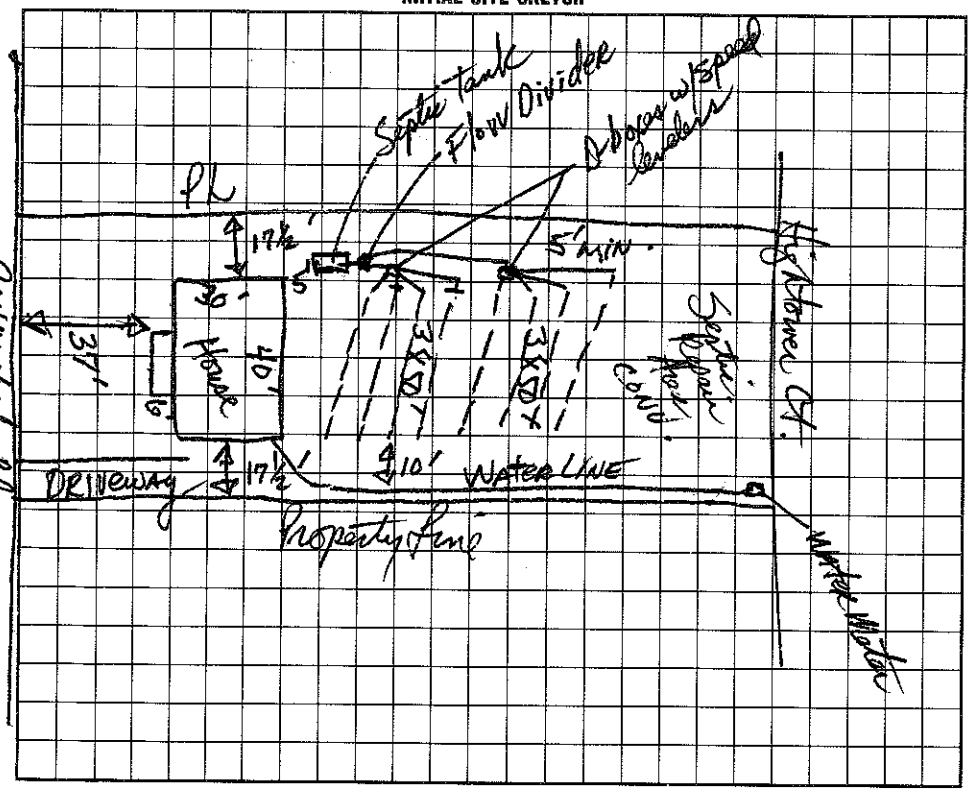

AS BUILT SKETCH

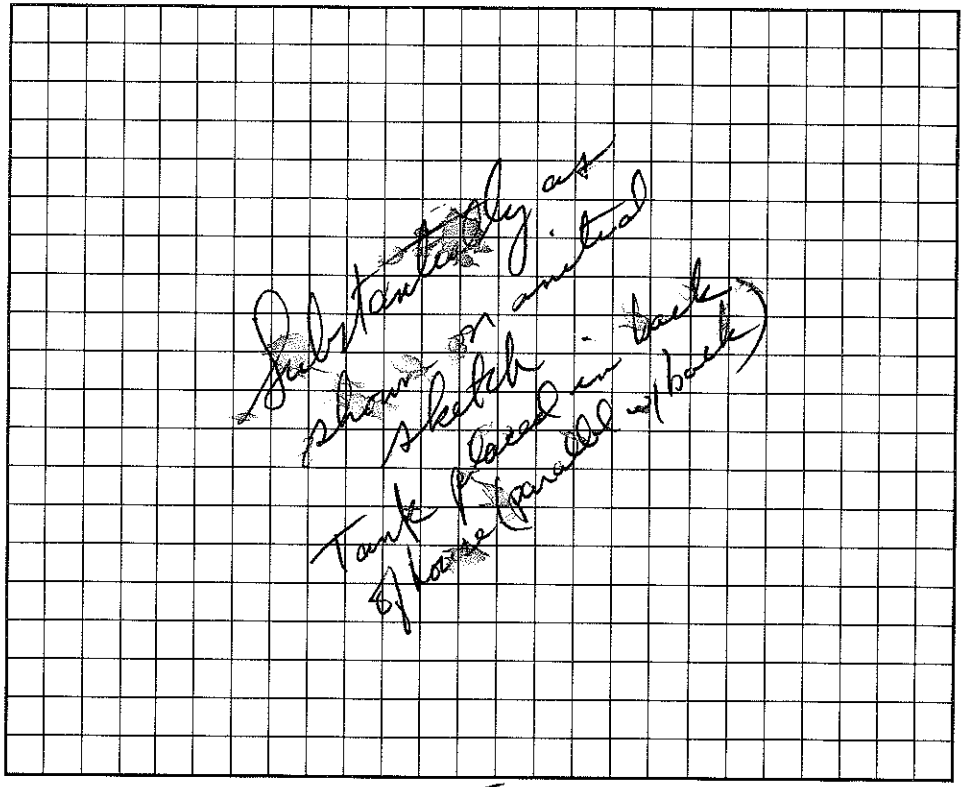

I understand that this permit can be suspended or revoked if any false information is supplied toward securing the permit/any unauthorized changes are made to the site/any unauthorized changes are made in the installation of the system. Improvement Permit is valid for 60 months from date of issuance.

Signed: X Newman McDade

Improvement Permit by: Frank R. Hinson, RS date 3/7/94

Existing System Inspection by: _____ date _____

Installed by: Richard Abernathy

Certificate of Completion by: James R. Hinson, RS date 7/6/94

Operation Permit by: _____ date _____

HEALTH DEPT COPY: WHITE INSPECTION COPY (FINAL): GREEN OWNER COPY (FINAL): YELLOW INSPECTION COPY (INITIAL): PINK OWNER COPY (INITIAL): GOLD