4636-88-7813

IREDELL COUNTY HEALTH DEPARTMENT

STATESVILLE 704-878-5305 MOORESVILLE 704-664-5281

IMPROVEMENT PERMIT / CERTIFICATE OF COMPLETION / OPERATION PERMIT / EXISTING SYSTEM INSPECTION

PROPERTY DESCRIPTION NO. 15805 DATE August 11, '93 TAX MAP NO. 2K-7A4

OWNER OR CONTRACTOR B&P Associates PHONE: Business Home

ADDRESS

LOCATION 1109 TL 1179 Canvasback on left ~300' past Regency Rd.

SUBDIVISION Regency Lake BLOCK / SECTION F LOT 4 LOT AREA SITE CLASS. PS L.T.A.R. .3

Water Supply: ☐ Individual ☑ Community ☐ Public

Septic Tank: 1000 Gallons; STB 825 (RST) Date 7-6-93

Pump Tank: Gallons; PT Date

Nitrification Field: No Fields 2 Square Feet 1200 Linear Feet 400

No Lines 8 Trench Width 36" Trench Depth ~36" Gravel Depth 12"

☑ New System ☐ Repair System Type: I, II, III, IV, V, VI

System Description: 9 Conventional

Repair System Description: SAME

Maintenance Agreement Required: ☐ Yes ☒ No

☑ House/Mod. Home No. Bedrooms 3

☐ Mobile Home No. Bathrooms 2

☐ Business No. Employees

☐ Other

☐ Slab ☑ Crawl Space ☐ Basement w/plumbing ☐ Basement wo/plumbing

Garbage Disposal: ☐ Yes ☑ No

Auto. Dishwasher: ☑ Yes ☐ No


Auto. Washing Machine: ☑ Yes ☐ No

Other

Comments

INITIAL SITE SKETCH

AS BUILT SKETCH

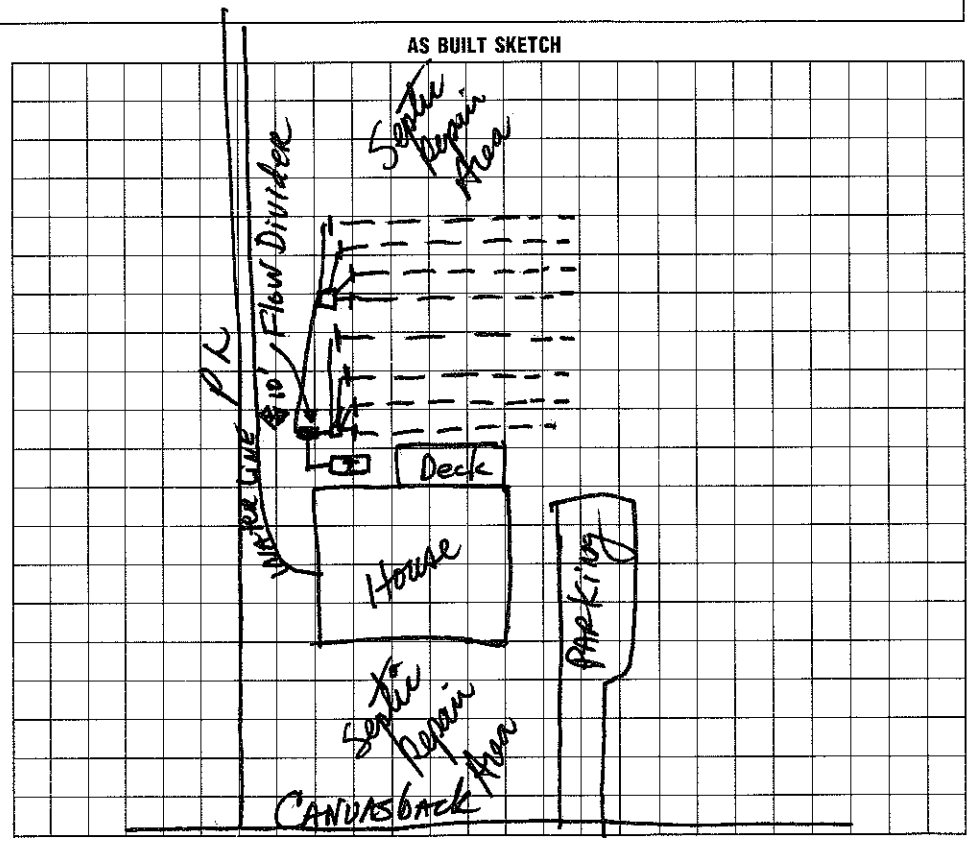

I understand that this permit can be suspended or revoked if any false information is supplied toward securing the permit/any unauthorized changes are made to the site/any unauthorized changes are made in the installation of the system. Improvement Permit is valid for 60 months from date of issuance.

Signed:

Installed by: Richard Abernathy

Improvement Permit by: date

Certificate of Completion by: date

Existing System Inspection by: date

Operation Permit by: Jack R Hinson, RS date 8/11/93

HEALTH DEPT. COPY: WHITE INSPECTION COPY (FINAL): GREEN OWNER COPY (FINAL): YELLOW INSPECTION COPY (INITIAL): PINK OWNER COPY (INITIAL): GOLD