IREDELL COUNTY HEALTH DEPARTMENT

Statesville Office (704) 878-5305 Mooresville Office (704) 660-3625 PERMIT # 180994

IMPROVEMENT PERMIT / AUTHORIZATION TO CONSTRUCT / OPERATION PERMIT / EXISTING SYSTEM

PIN # 4636-88-8237

APPLICANT: Joy Seal APPLICANT ADDRESS: 103 Wood Duck Lp Mooresville NC 28117

SITE ADDRESS: 103 Wood Duck Lp Mooresville NC 28117 PHONE: 724-272-7351 ALT. PHONE:

SITE DIRECTIONS: Brawley Sch Rd, TL on Canvasback Rd, TL on Wood Duck Lp, House on Corner of Canvasback & Wood Duck


SUBDIVISION: LAKESIDE FARM SECTION: 1 LOT # 1 LOT AREA: 0.69 ac DESIGN FLOW: 480 L.T.A.R.: 0.25

Septic Tank	EXISTING 1000 (gal)	STB		Date		☐ New System	☐ Repair	☑ Expansion	System Type: I II (III) IV V VI	☑ Residence	No. Bedrooms 4
Pump Tank	(gal)	PT		Date		System Description:	25% Reduction Gravity			☐ Business	No. Persons 8
Pump Make	Model		Serial #			Repair System Description:	LP PPBPS			☐ Other	No. Employees
# Nitrification Fields	1	# Lines	2	Linear Ft:	120'	Maintenance Agreement Required:	☐ YES	☑ NO		☐ Slab	☐ Crawl Space
Trench Width	36"	Max. Trench Bottom Depth	24"	Gravel Depth	N/A	☑ GRAVITY	☐ PRESSURE			☑ Basement w/plumbing	☐ Basement w/o plumbing

Water Supply: ☐ Private ☐ Public ☑ Community

Comments / Conditions: Connect to existing DB @ end of last existing line, Before repair area is used drain beside driveway must be removed.

INITIAL SITE SKETCH

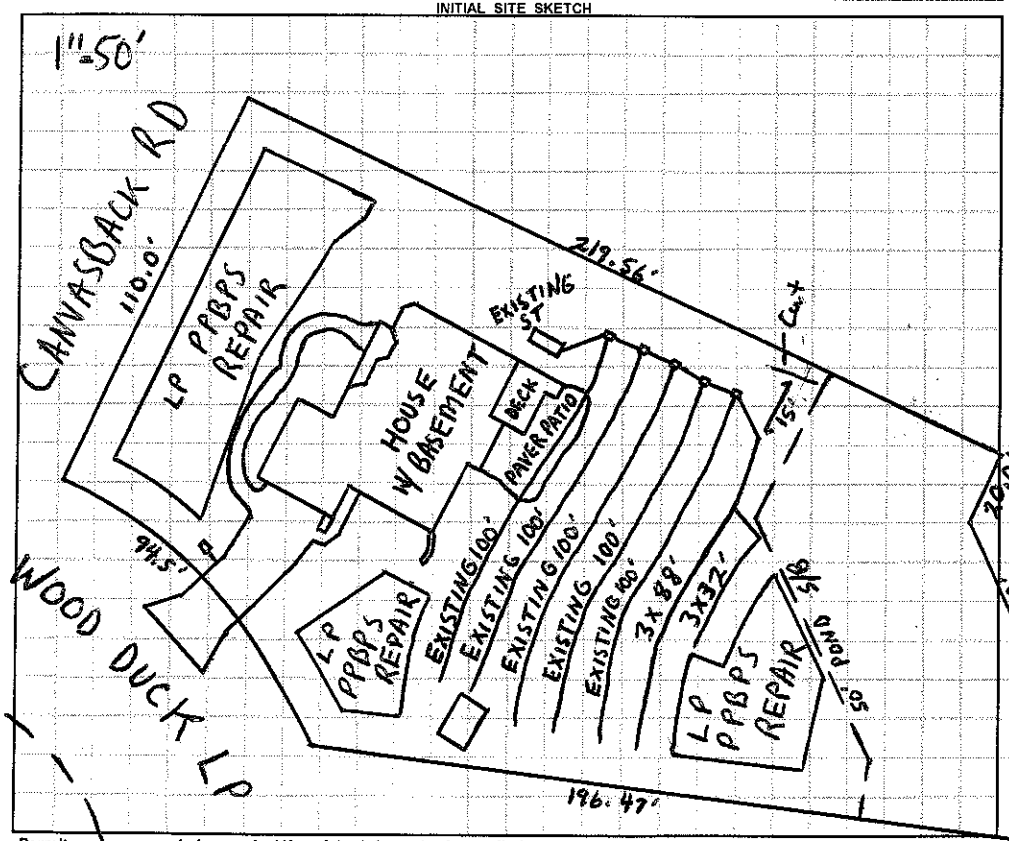

AS BUILT SKETCH

*Installed as Drawn

*IQ4W Installed

Permit can be suspended or revoked if any false information is supplied toward securing the permit / any unauthorized changes are made to the site / any unauthorized changes are made in the installation of the system. **CONTACT A LOCATOR SERVICE PRIOR TO ANY EXCAVATION**

☐ **IMPROVEMENT PERMIT** *with plat valid without expiration.* ☐ **IMPROVEMENT PERMIT** *with site plan valid for 60 mos.* ☑ **AUTHORIZATION TO CONSTRUCT** *valid for period equal to IMPROVEMENT PERMIT--not to exceed 60 mo.*

Owner / Applicant Signature: Joy & Constantin Seal Date: 12-10-13 Installed by: Piedmont Backhoe

IMPROVEMENT PERMIT by: Mia L. Pruett Date: 12-6-13 OPERATION PERMIT by: Mia L. Pruett Date: 2-7-14

AUTHORIZATION TO CONSTRUCT by: Mia L. Pruett Date: 12-6-13 Existing System Inspected by: Date:

Health Dept. Copy - WHITE Applicant (Final Approval) - YELLOW Applicant (Conditional Approval) - PINK