IREDELL COUNTY HEALTH DEPARTMENT

STATESVILLE 704-878-5305 MOORESVILLE 704-664-5281

IMPROVEMENT PERMIT / AUTHORIZATION TO CONSTRUCT / OPERATION PERMIT / EXISTING SYSTEM INSPECTION

PERMIT# 083584 PIN# 4636 88 9146 4636 88 9147 DATE 1/28/00

OWNER OR CONTRACTOR Dany Tucker PHONE: Business _____ Home 463-0213

ADDRESS 106 Sand Reed Dr. Mooresville, NC. 28117

LOCATION 1ST Woodduck Loop - 1100 TL Canvasback TL 1ST Woodduck Loop, 1ST lot on (L)

SUBDIVISION LAKESIDE FARM BLOCK / SECTION 1 LOT 2 LOT AREA < 30,000 FT² SITE CLASS PS DESIGN FLOW 360 L.T.A.R. .3

Septic Tank: 1000 Gallons; STB 794 Date 12/4/00
Pump Tank: 1000 Gallons; PT 283 Date 5/7/00
Pump Make: HYDRO Model SK60M Serial No. 11/00
Nitrification Field: No Fields 1 Square Feet 900 * Linear Feet 300 *
No Lines 5@60'x3' Trench Width 36" Max Trench Bottom Depth 36" Gravel Depth SAND


[X] New System [ ] Repair System Type: I, II, (III), IV, V, VI
System Description: 25% Reduced - 4DSOR CH. PL
Repair System Description: 16" PPBS
Maintenance Agreement Required: [ ] Yes [X] No 1/2
[ ] Slab [ ] Crawl Space [X] Basement w/plumbing [ ] Basement wo/plumbing

[X] House/Mod. Home No. Bedrooms 3
[ ] Mobile Home No. Bathrooms 3
[ ] Business No. Employees ____
[ ] Other ____

Water Supply: [ ] Individual [ ] Public [X] Community


Comments/Conditions:

INITIAL SITE SKETCH

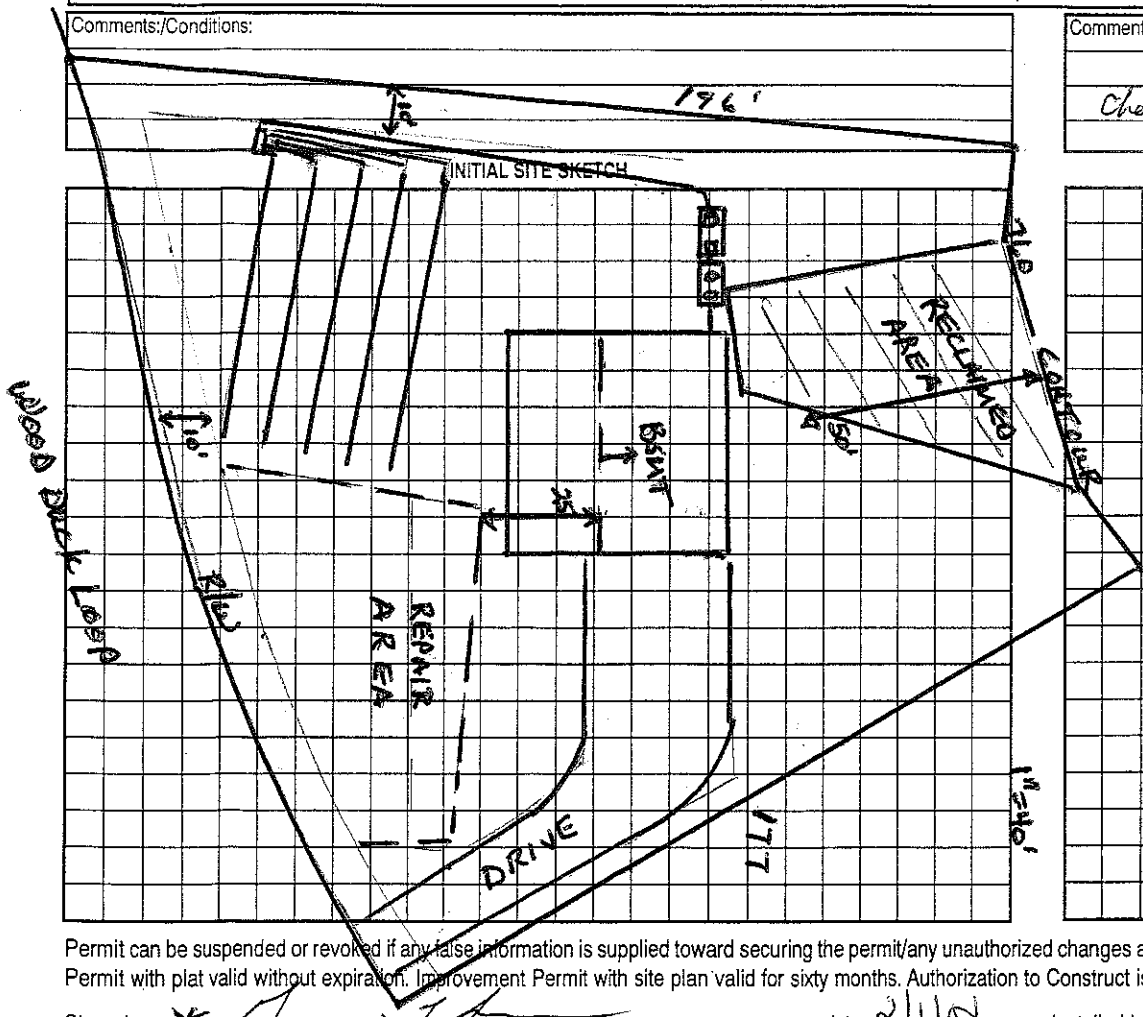

Comments/Conditions: Tanks, Pressure, Lines, Pres Man.
Checked Plans & Electrical Hookup PBA

AS BUILT SKETCH

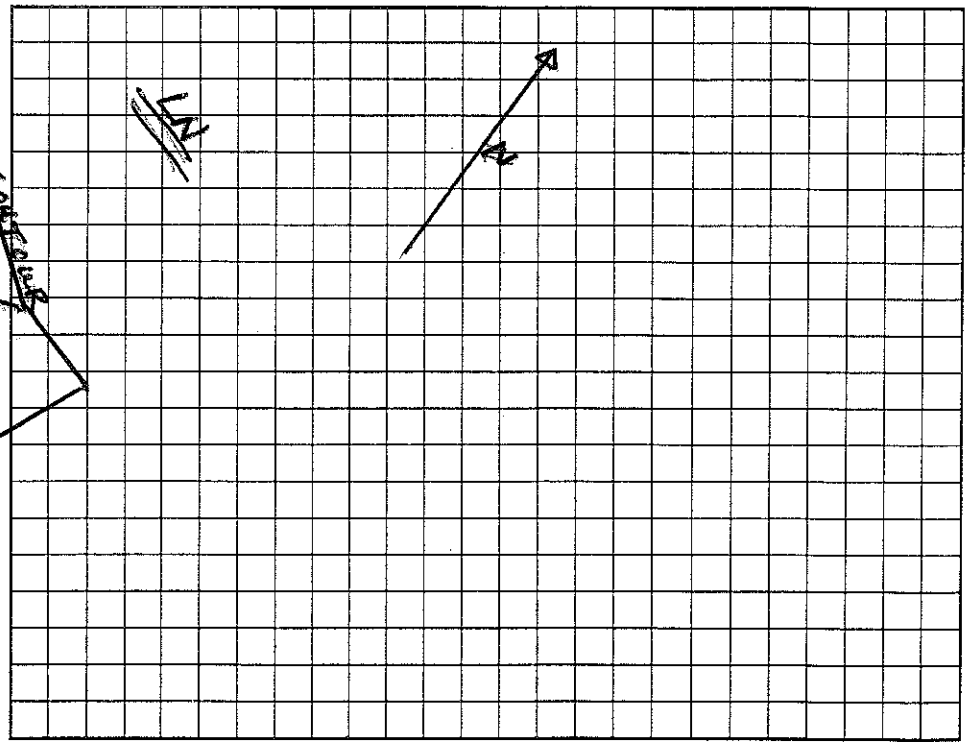

Permit can be suspended or revoked if any false information is supplied toward securing the permit/any unauthorized changes are made to the site/any unauthorized changes are made in the installation of the system. Improvement Permit with plat valid without expiration. Improvement Permit with site plan valid for sixty months. Authorization to Construct is valid for a period equal to that of Improvement Permit – not to exceed sixty months.

Signed: * Dany Tucker date 2/1/00 Installed by: Curt Dunnuck

Improvement Permit by: Wesley Sparks RS. date 1/28/00 Operation Permit by: Walter P. Hudson, RS date 2-28-01

Authorization to Construct by: Wesley Sparks RS. date 1/28/00 Existing System Inspection by: _____ date _____

HEALTH DEPT. COPY: WHITE OWNER COPY (FINAL): YELLOW OWNER COPY (INITIAL): PINK