IREDELL COUNTY HEALTH DEPARTMENT

SVILLE 704-878-5305 MOORESVILLE 704-664-5281

IMPROVEMENT PERMIT / AUTHORIZATION TO CONS...UCT / OPERATION PERMIT / EXISTING SYSTEM INSPECTION

PERMIT# 092207 PIN# 4663698 0414 4636-88-9485 DATE 11/29/2000

OWNER OR CONTRACTOR Jim Bremer PHONE: Business _____ Home 664-3824

ADDRESS 134 Hightower Ct. Mooresville NC 28117

LOCATION Brawley School Rd TL Canvasback TL Regency TR Hightower Ct on right

SUBDIVISION Regency Lk Village BLOCK / SECTION E LOT 8&9 LOT AREA _____ SITE CLASS PS DESIGN FLOW 360gpd L.T.A.R. .3

Septic Tank: 1000 Gallons; STB 1012 Date 10/27/00

Pump Tank: _____ Gallons; PT _____ Date _____

Pump Make: _____ Model _____ Serial No. _____

Nitrification Field: No Fields 1 Square Feet 1206 Linear Feet 402'

No Lines 6 at 67' Trench Width 36" Max Trench Bottom Depth 36" Gravel Depth 12"

☐ New System ☐ Repair System Type: I, II, III, IV, V, VI

System Description: Gravity - Conventional

Repair System Description: Pumped - Modified

Maintenance Agreement Required: ☐ Yes ☒ No

☐ House/Mod. Home ☒ Mobile Home ☐ Business ☐ Other

No. Bedrooms 3 No. Bathrooms 2 No. Employees ____


☐ Slab ☒ Crawl Space ☐ Basement w/plumbing ☐ Basement wo/plumbing

Water Supply: ☐ Individual ☒ Public ☒ Community


Comments:/Conditions: Keep Septic System at least 10' From PL, 5' from house & 20' From any other drainfield.

Comments:/Conditions: * Lots 8&9 were Combined to meet Zoning setbacks; Existing Mh on Lot 8 will be removed. Septic drainfield repair area can be on Lot 8.

INITIAL SITE SKETCH Scale 1:50

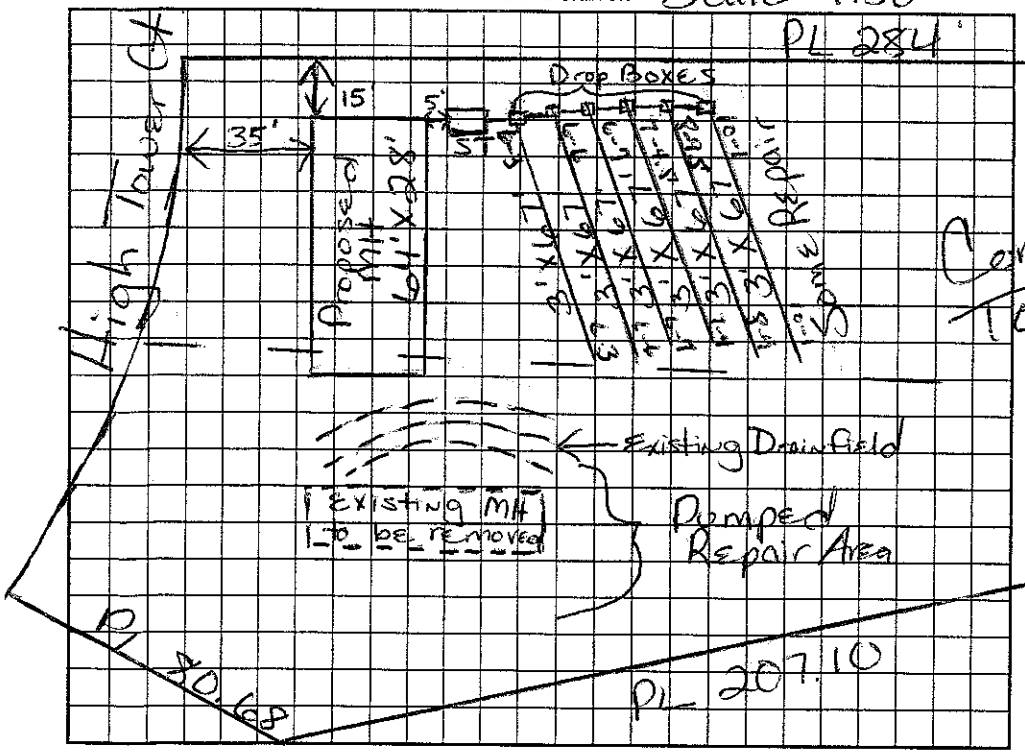

AS BUILT SKETCH

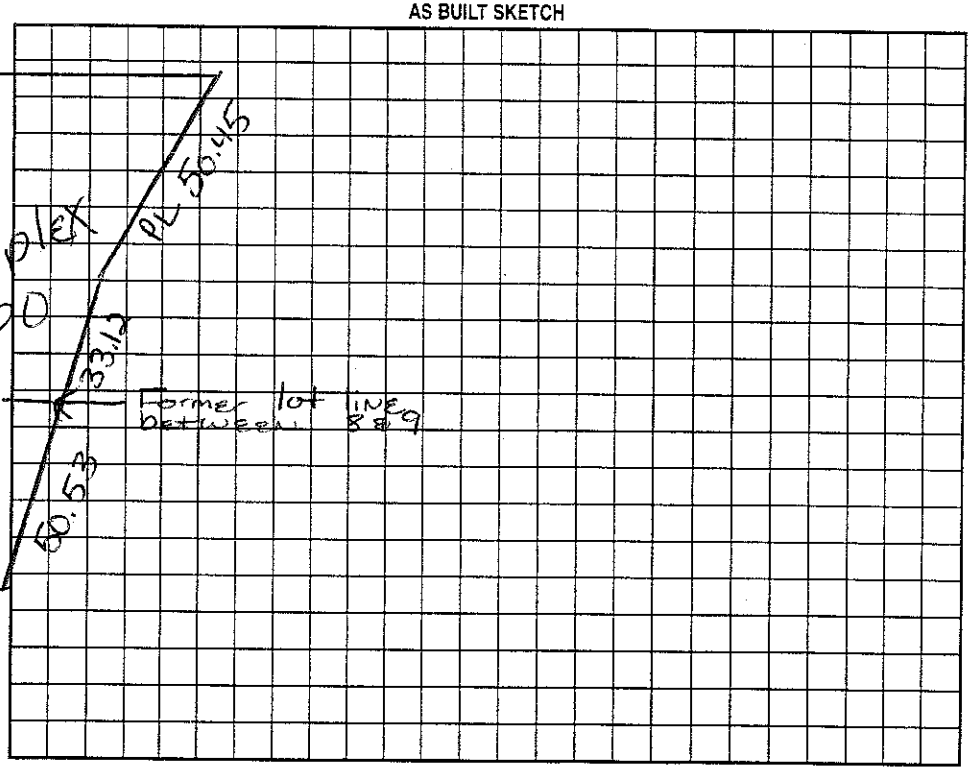

Permit can be suspended or revoked if any false information is supplied toward securing the permit/any unauthorized changes are made to the site/any unauthorized changes are made in the installation of the system. Improvement Permit with plat valid without expiration. Improvement Permit with site plan valid for sixty months. Authorization to Construct is valid for a period equal to that of Improvement Permit – not to exceed sixty months.

Signed: X Linda Bremer date 11/30/00 Installed by: Craig Thompson

Improvement Permit by: Maria H. Dotson RS date 11/29/2000 Operation Permit by: Wesley Sparks RS. date 12/12/00

Authorization to Construct by: Maria H. Dotson R.S date 11/29/2000 Existing System Inspection by: _____ date _____

HEALTH DEPT. COPY: WHITE OWNER COPY (FINAL): YELLOW OWNER COPY (INITIAL): PINK